


T.27S., R.17E., W.M.

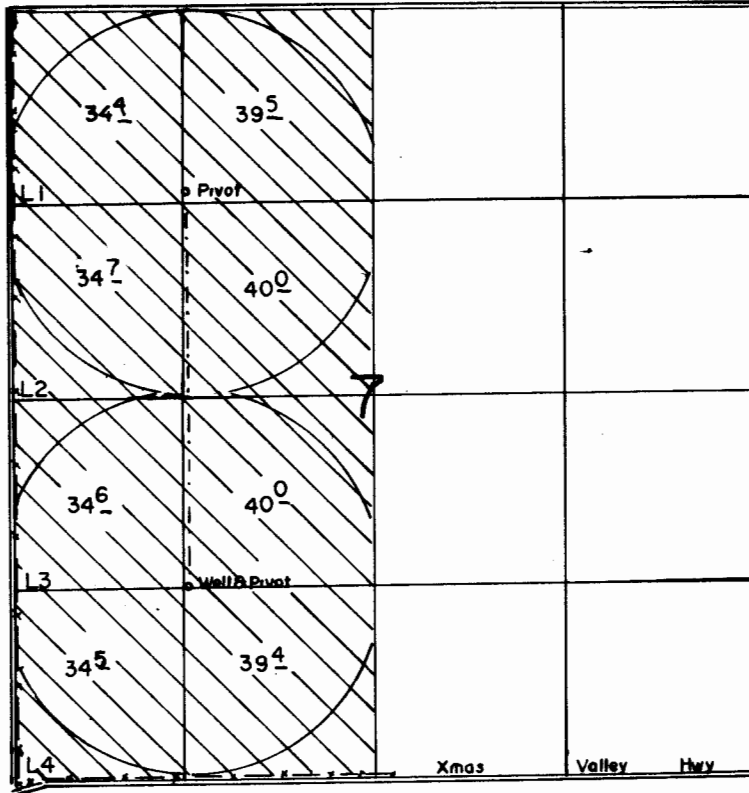

Well Loc 1360' N @ 1220' E From The SW Corner Of Section 7

SCALE: 1"=1320'

FINAL PROOF SURVEY
UNDER

Application No. G-10119.. Permit No. G-95.64....
IN NAME OF

.....MARION.....O.....HUEBNER.....

Surveyed JULY..27.. 19.8.9., by B.W..BISHOP.....