


T.23S, R.46E, W.M.
T.24S, R.46E, W.M.

T.25S, R.46E, W.M.
T.26S, R.46E, W.M.

OREGON
IDAHO
ONVHLEE CO.

T.27S, R.46E, W.M.
T.27S, R.47E, W.M.

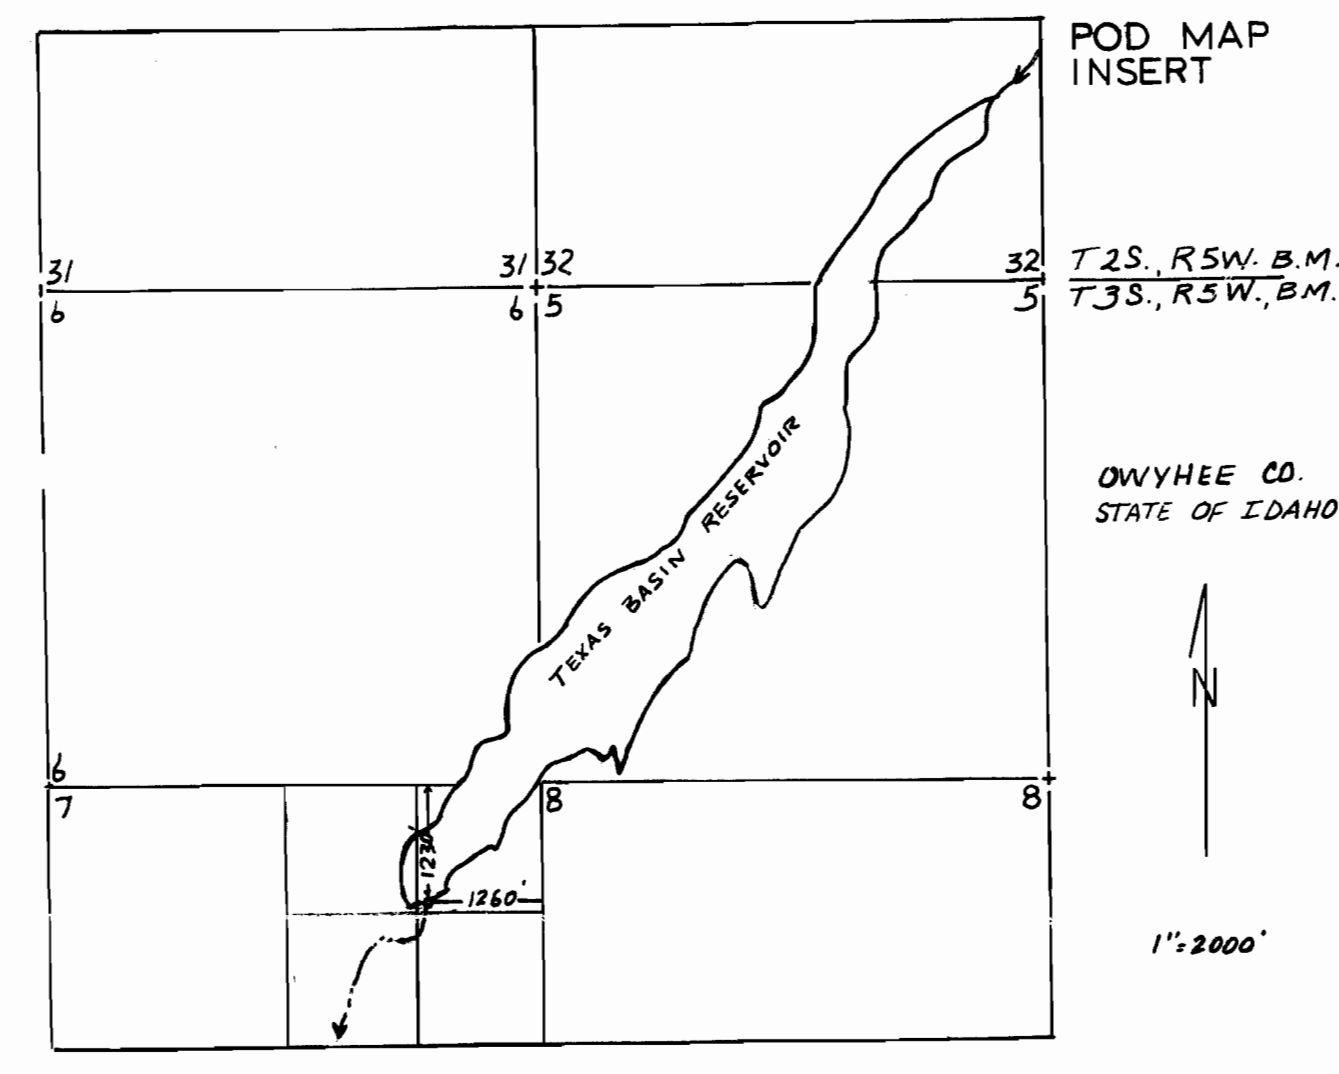

FINAL PROOF SURVEY
UNDER
Application No. 53811 Permit No. 40584
R-53810 R-6469
SUCCOR CREEK DIST. IMPROVEMENT CO.

Surveyed 2-1994; 10-1994 by J. Miller