


T. 29 S., R. 6 W., W. M.

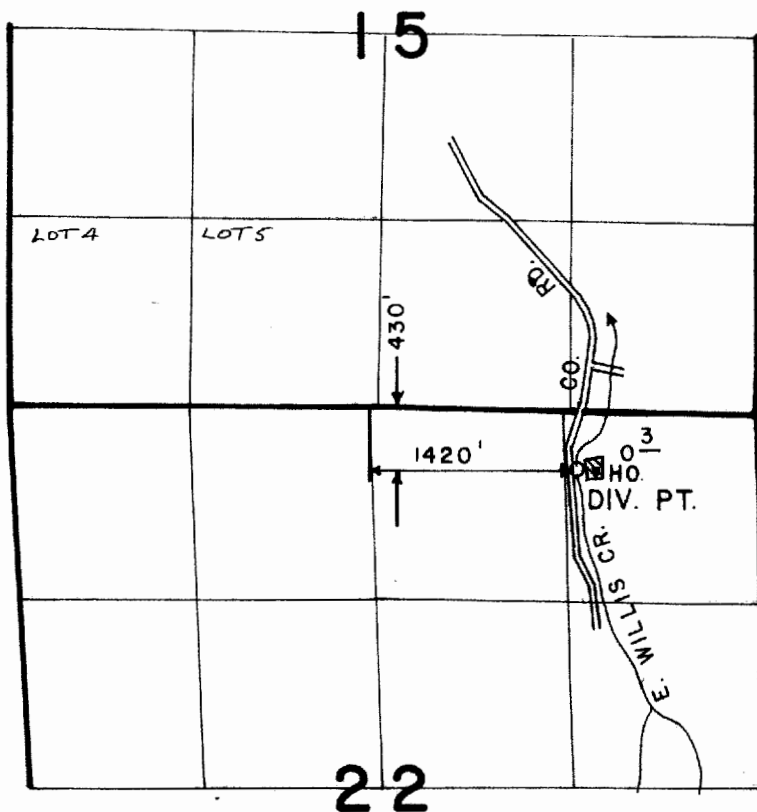

SCALE: 4" = 1 MILE

FINAL PROOF SURVEY
UNDER

Application No. 52376 Permit No. 39405.....
IN NAME OF

.....LEO MEREL TAYLOR.....

Surveyed JUNE 18, 1987., by J. M. SCHMORDE