


RECEIVED

JUL 12 1996

UNITED STATES WATER RESOURCES DEPT.
DEPARTMENT OF THE INTERIOR OREGON
GEOLOGICAL SURVEY

RECEIVED
JAN - 4 1995

2.70 N SE
1 STINKING LAKE

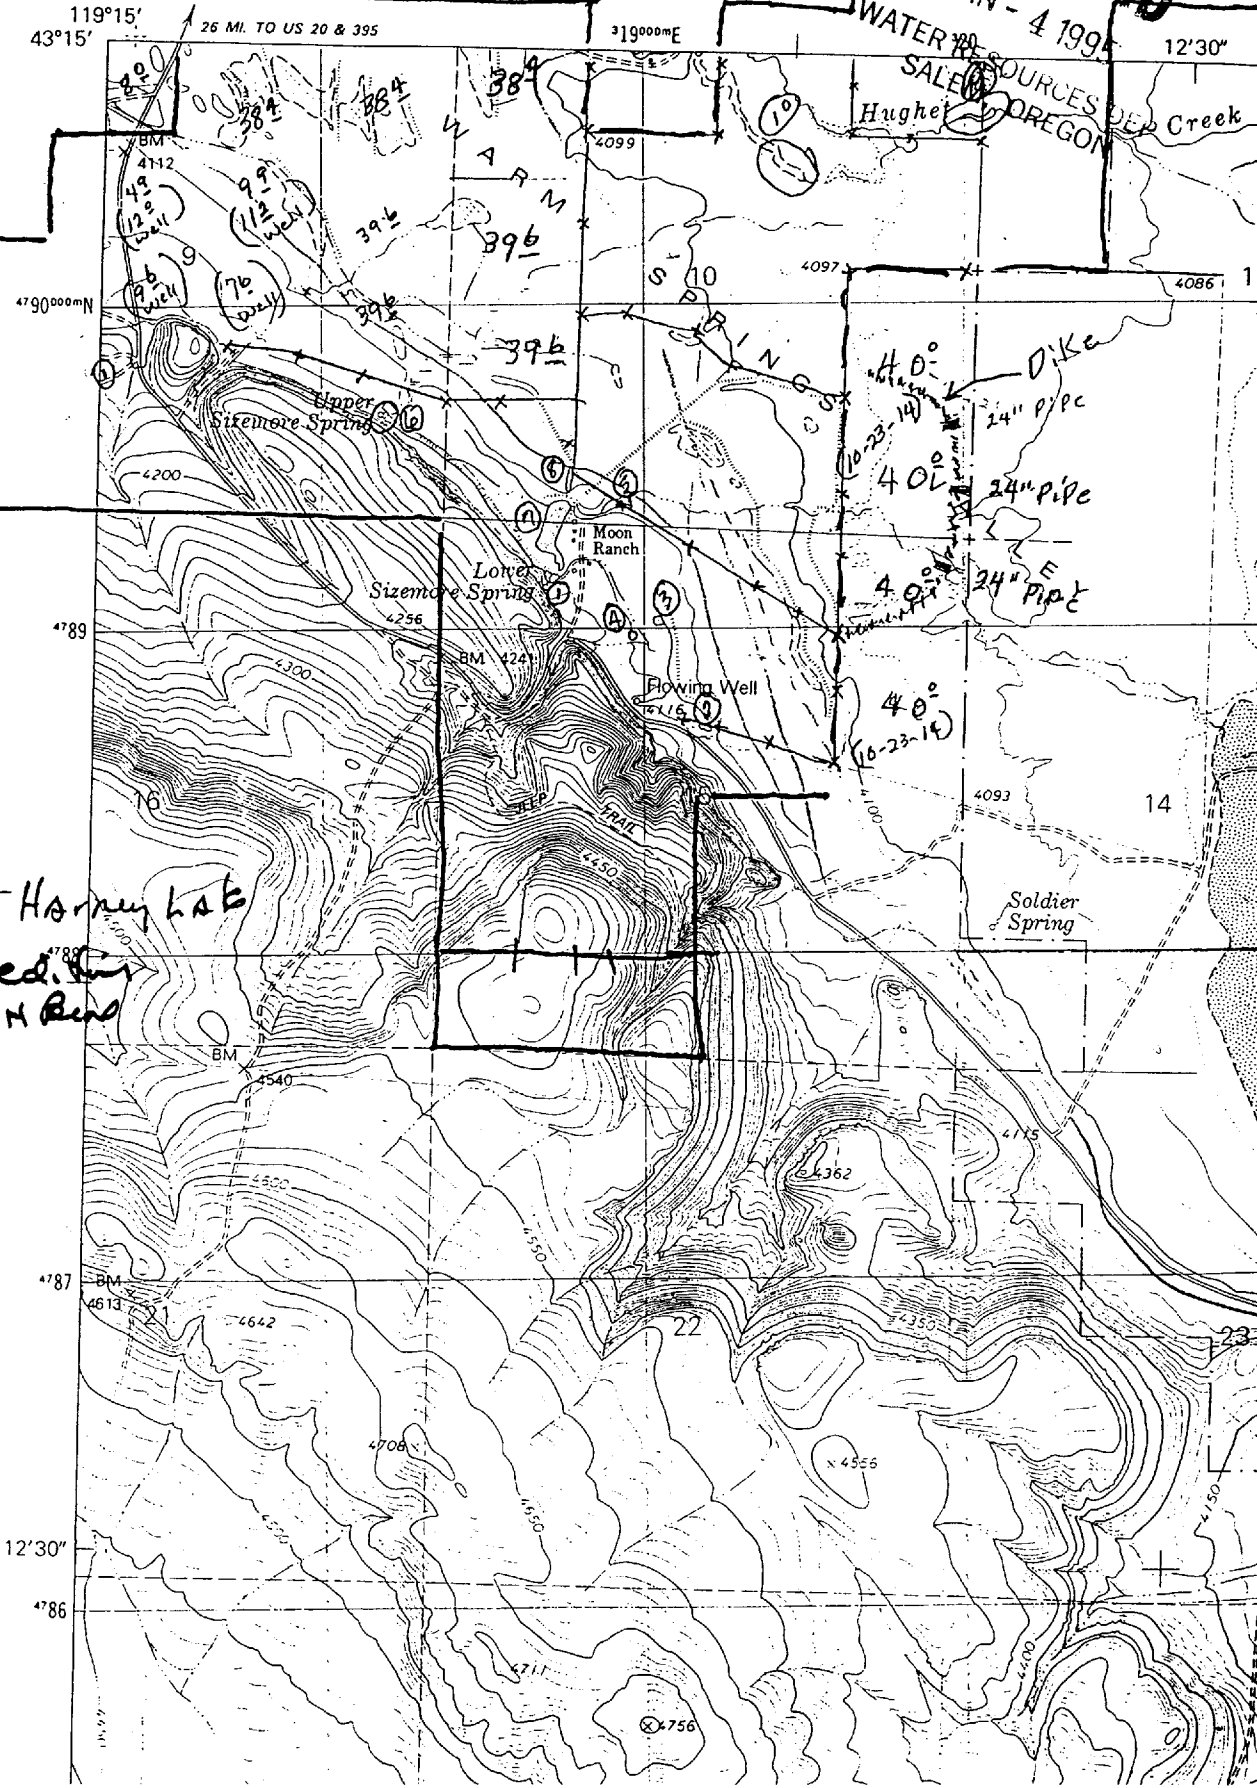

App. No. 83396
Permit No. 80722
Certifica &

South west Horney Lake
1980 ed. by
W N Bend

T-27-S
R-29-E

Oregon

WATER RESOURCES

DEPARTMENT
RECEIVED

Watermaster
JAN - 4 1995

WATER RESOURCES DEP
SALEM, OREGON

SECTION 1/4 1/4

INSTREAM

WATER

RECEIVED

JUL 12 1996

WATER RESOURCES DEPT.
SALEM, OREGON

ACRES

ACRE FEE

RECEIVED

AUG 19 1996

MAX DEPTH
WATER RESOURCES DEPT.
SALEM, OREGON

SPILLWAY

TAX LOT

QUADRANGLE MAP

DRAINAGE AREA

01	27 ⁵	29 ⁴	SW NE NE	10	10	Hect	6'	2.2	2.4	5'	PIPE	300	Southwest Hornet Lake	
10	27 ⁵	29 ⁴	SW SW	10	10	Hect	6'	2.2	2.4	5'	PIPE	300	Harold Lake	

Application No. 83346
Permit No.

