


T.4 S.R. 1 & 2 W.W.M.

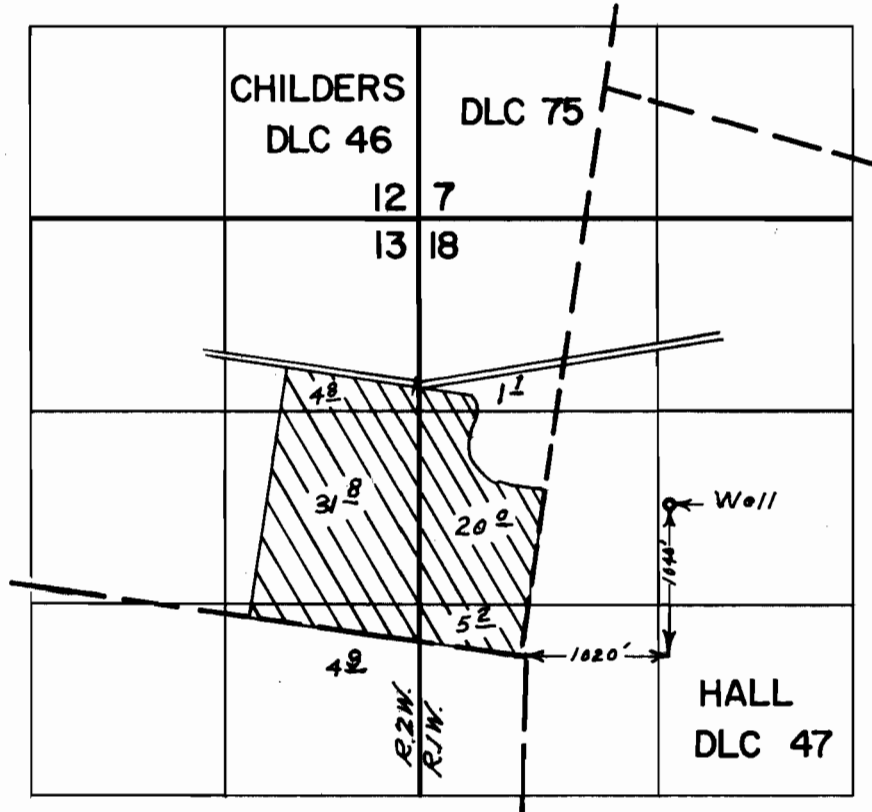

FINAL PROOF SURVEY UNDER

Application No. G-4183 Permit No. G-3951
IN NAME OF

FRANCIS X. RYAN

Surveyed AUG 16 19 73, by L.E. GOULD