


# T. 36 S. R. 6 W. W.M.

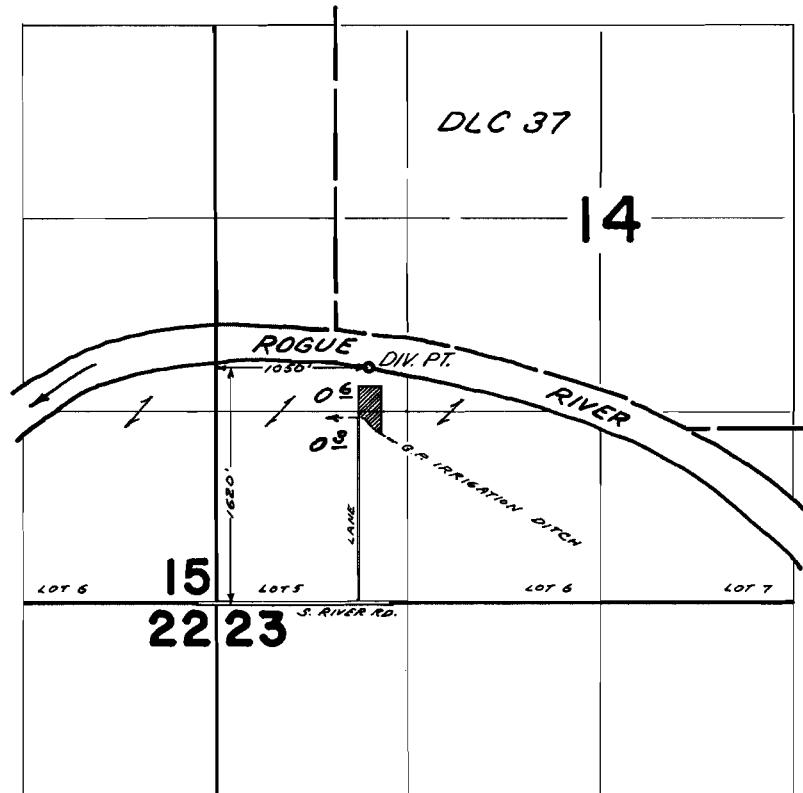

## FINAL PROOF SURVEY UNDER

Application No. 49059 Permit No. 32922  
IN NAME OF

ESTATE OF ERNEST N. DONNELLY

Surveyed JUN 7 1969, by D. BUELL