


34375

56-6-36

T.36S.R.6W.W.M.

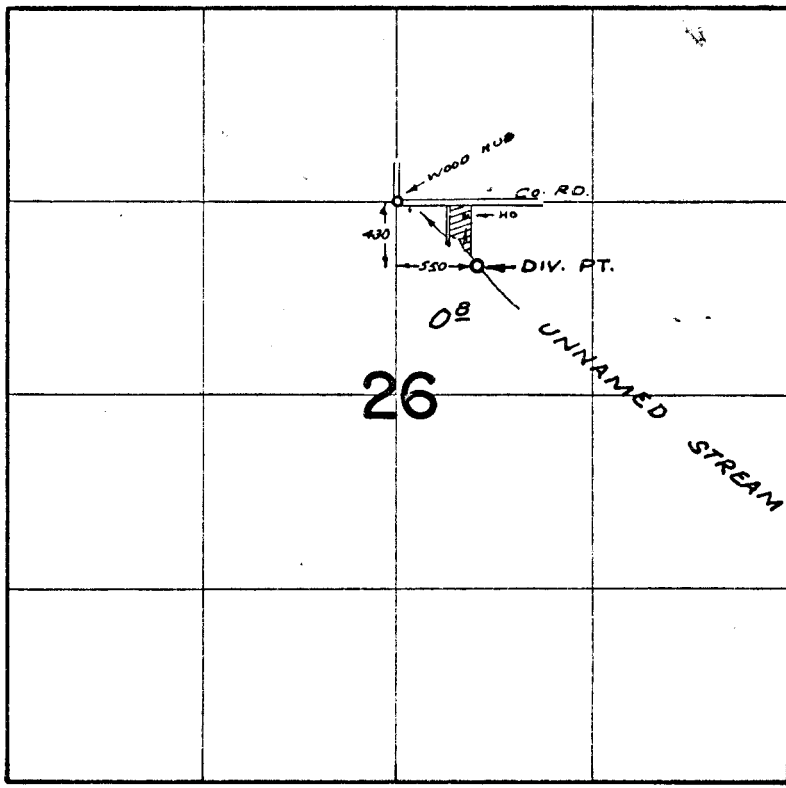

FINAL PROOF SURVEY UNDER

Application No. 46030 Permit No. 34375
IN NAME OF

EMMA Mc ALLISTER

Surveyed APR. 20, 1972, by R. MUGKEN

C-214