


G-7480

55174
T923
80757
T923

T.26S.,R.15E.,W.M.

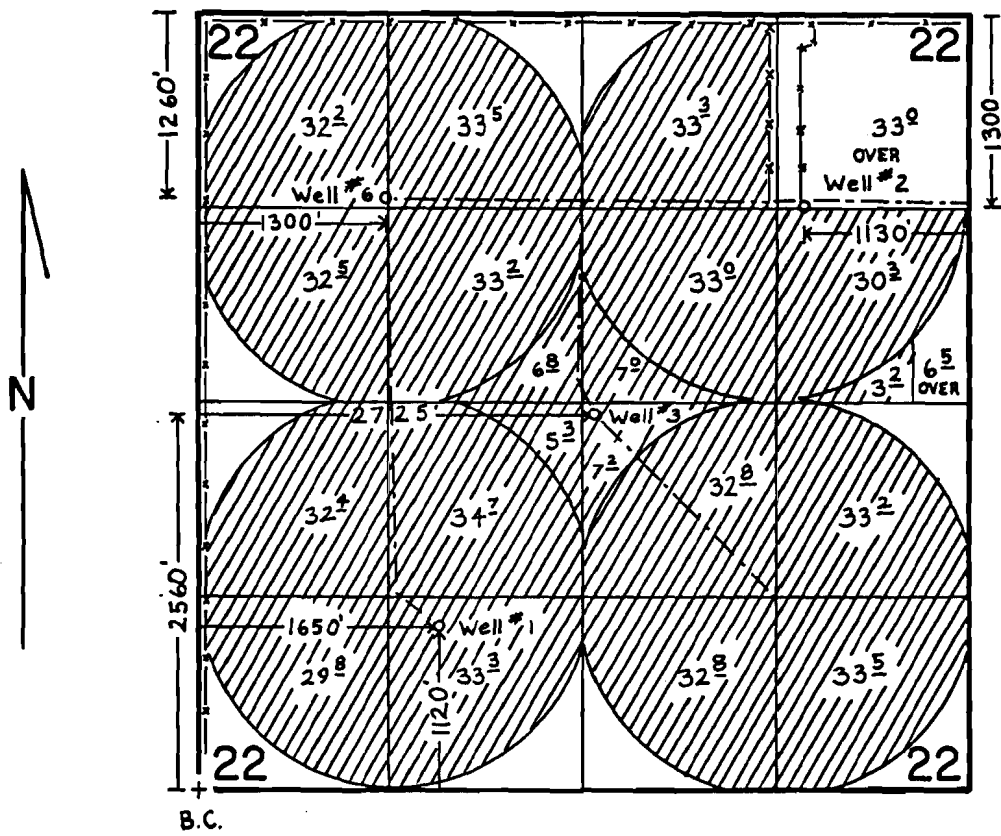

SCALE: 1" = 1320'

FINAL PROOF SURVEY UNDER

G-8093 G-7480
Application No. ~~G-8094~~ Permit No. ~~G-7481~~.....
IN NAME OF

THEODORE R. TIAHRT

Surveyed JUNE 18... 1985., by LESLIE OLSON....