


# T.26S.,R.15E.,W.M.

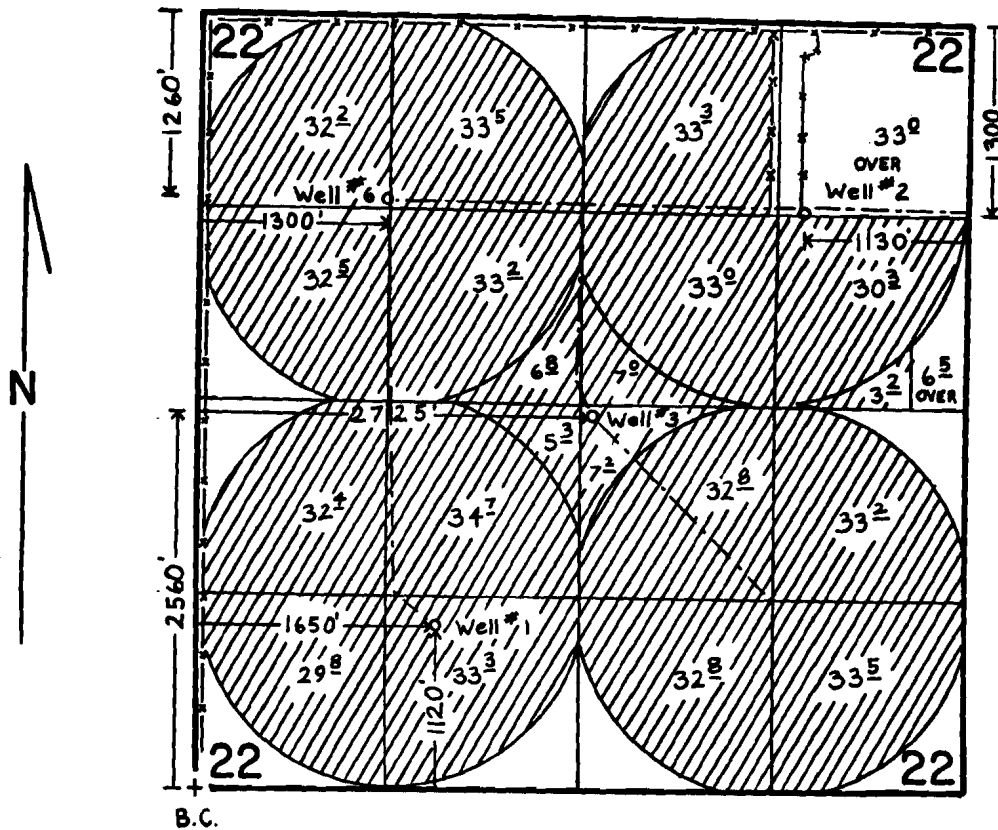

SCALE: 1" = 1320'

## FINAL PROOF SURVEY UNDER

G-8093                      G-7480  
Application No. G-8094. Permit No. G-7481.....  
IN NAME OF

.....THEODORE R. TIAHRT.....

Surveyed JUNE 18... 1985... by LESLIE OLSON....