


T. 1N. R. 27 & 28 E. W.M.

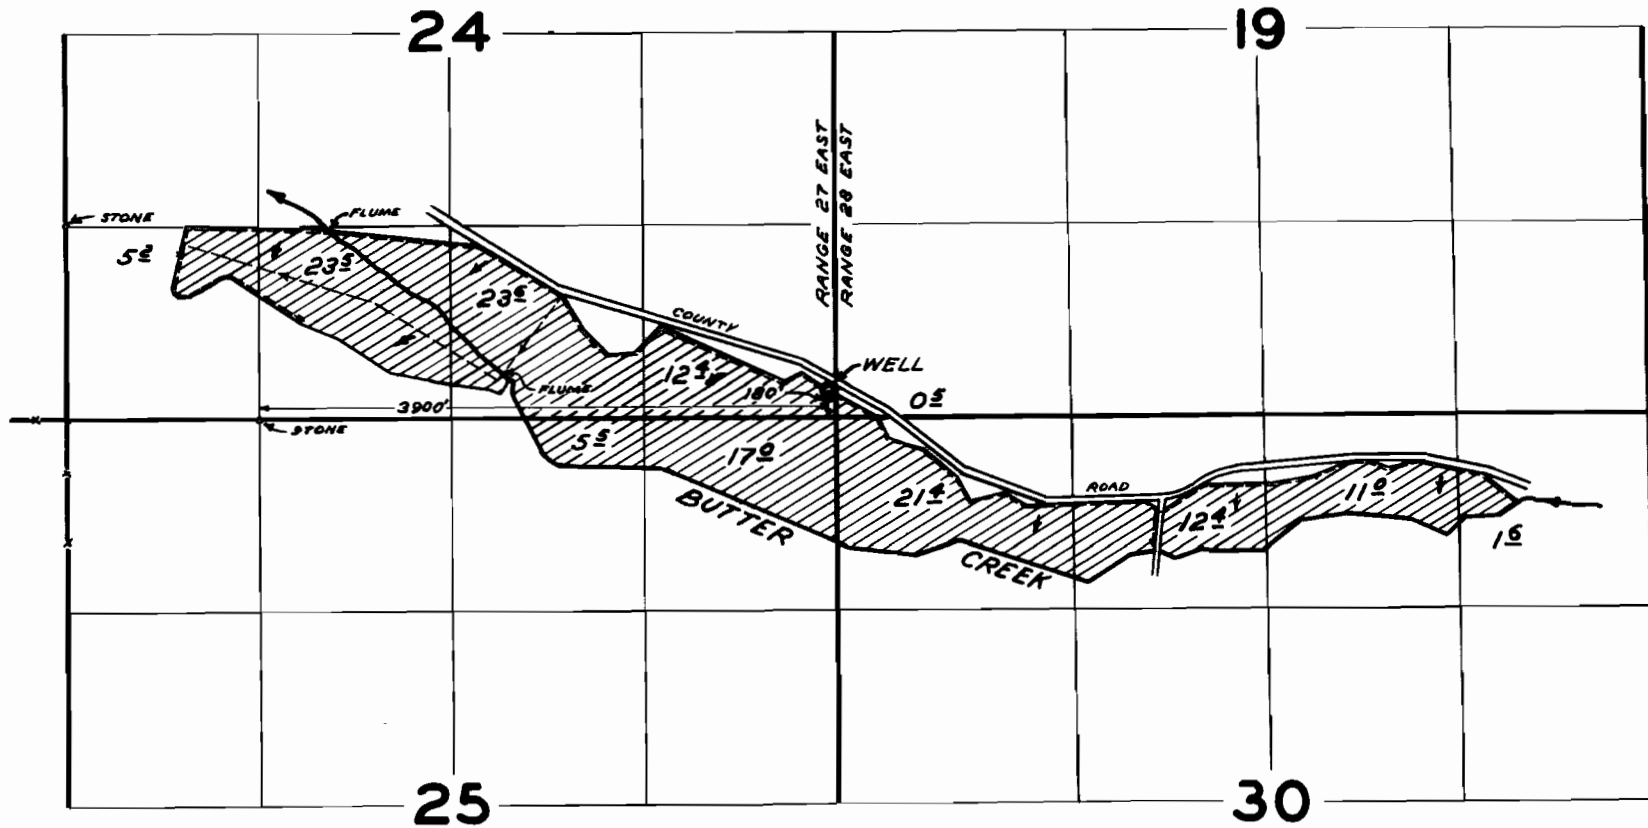

FINAL PROOF SURVEY UNDER

APPLICATION NO. G-784, PERMIT NO. G-681

IN NAME OF
A. J. VEY

SURVEYED JUNE 27, 1966 BY L. GOULD