


# T.1N.R.27E.W.M.

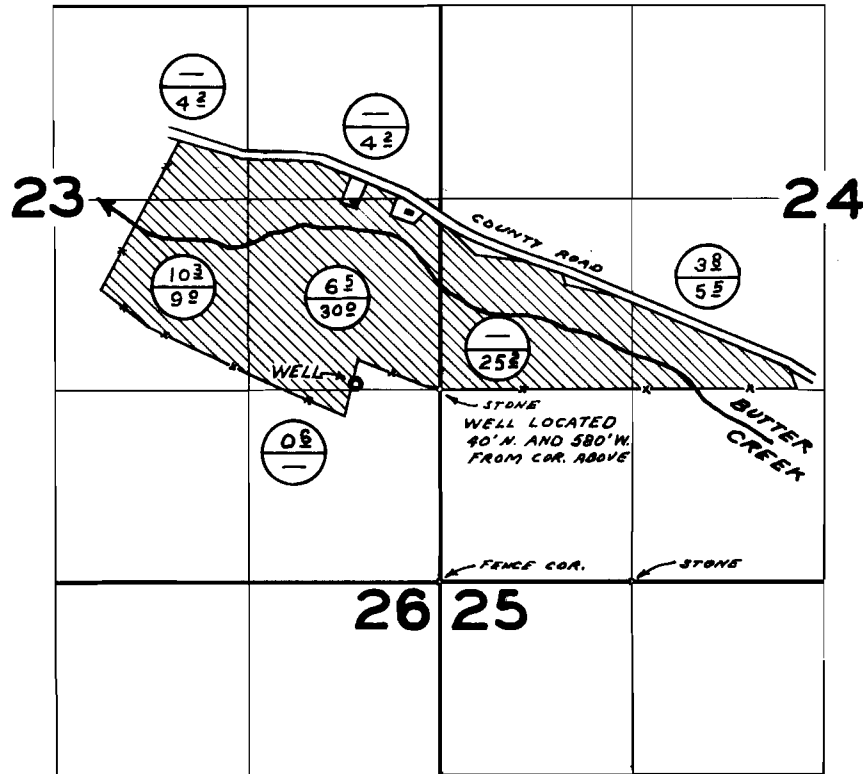

## FINAL PROOF SURVEY UNDER

Application No. G-3002 Permit No. G-2797  
IN NAME OF

RAYMOND M. PORTER & SONS

Surveyed JUN. 27 1966, by L. GOULD