


9/17/02 the location of the section lines are in error.
Please see Gosson, info.
[Signature]

T.28S.,R.4W.,W.M.

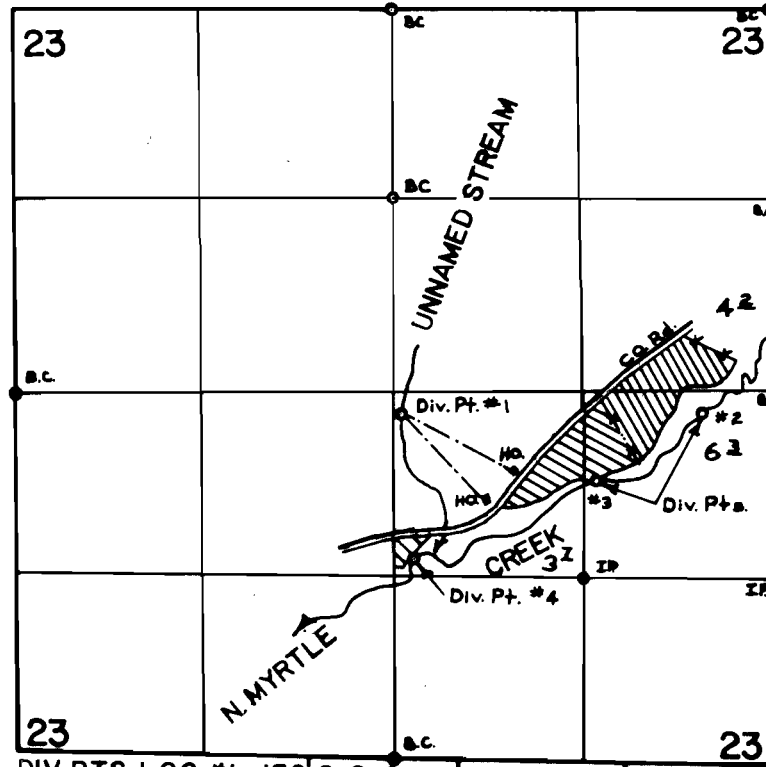

DIV. PTS. LOC: #1- 150' S. & 2580' W.; #2- 150' S. & 520' W.;
#3- 610' S. & 1240' W.; #4- 1130' S. & 2490' W.; ALL
FROM E. 1/4 COR. SEC. 23

FINAL PROOF SURVEY UNDER

Application No. 49450... Permit No. 37043...
IN NAME OF

W. M. MATSCHKOWSKY & R. A. ARCHULETA

Surveyed OCT. 4... 1977, by D. W. SPARKS...