


T.28S., R.4W., W.M.

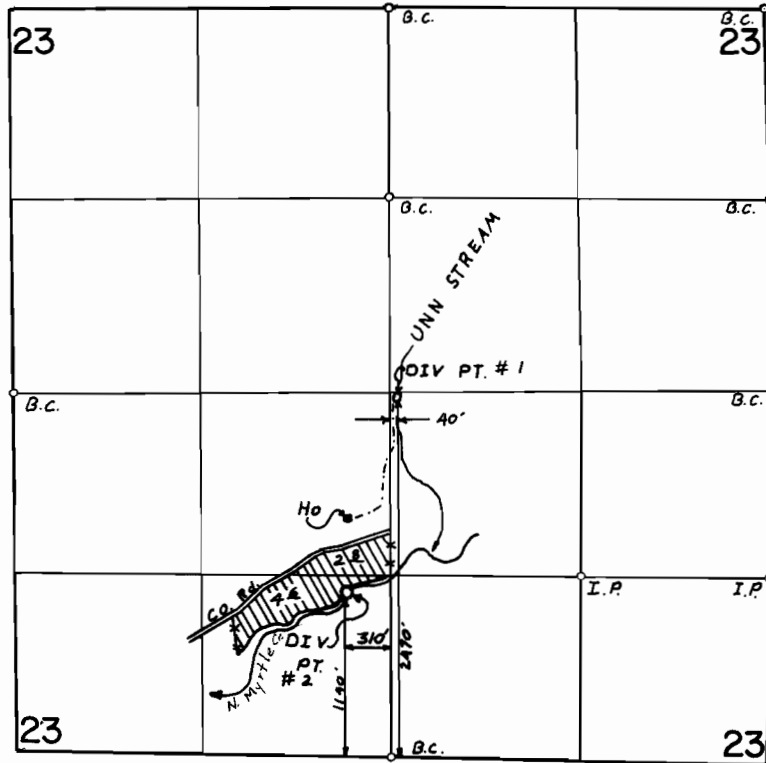

**FINAL PROOF SURVEY**  
UNDER

Application No. 49236 Permit No. 36902  
IN NAME OF  
DONALD L. OR ELIZABETH A. FITZPATRICK  
Surveyed OCT. 4, 1977, by D.W. SPARKS