


T.2S. R.38E. W.M.  
T.3S. R.38E. W.M.

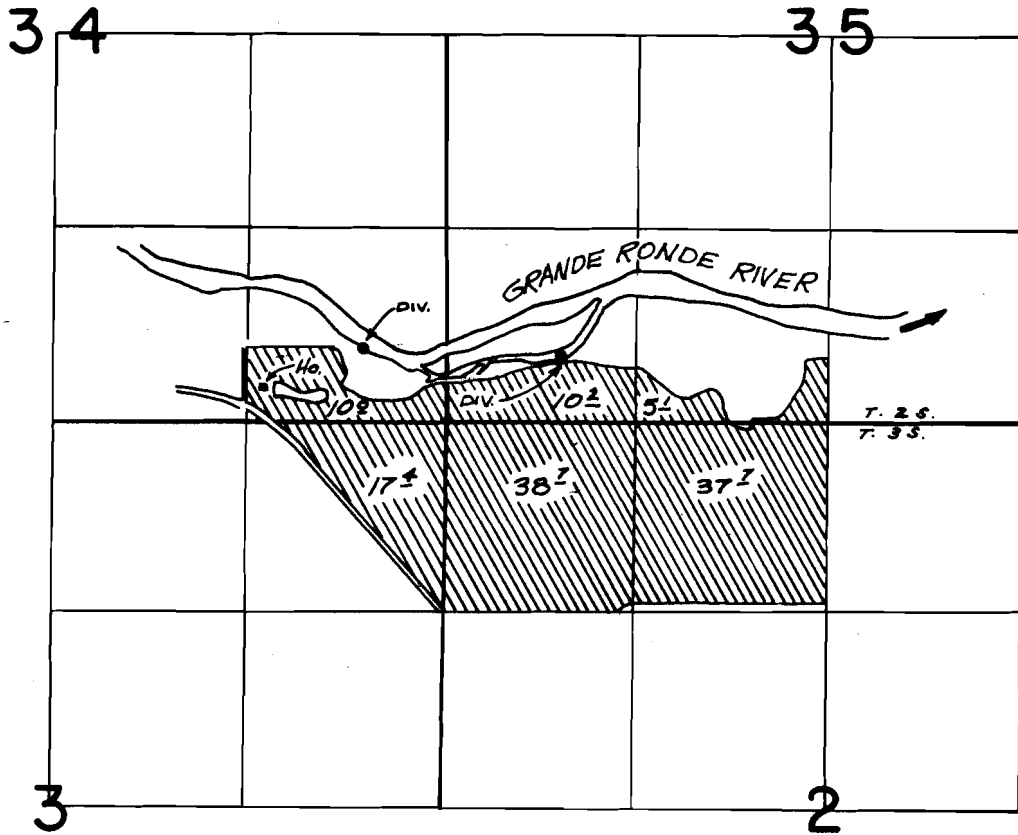

DIV. PTS. 500' N. 575' W., 450' N. 775' E. BOTH FROM SE. COR. SEC. 34

**FINAL PROOF SURVEY**  
UNDER

Application No. 41889 Permit No. 31353  
IN NAME OF

ELTON MUILENBURG

Surveyed July 16 1973, by R. MUCKEN