





# T. 26 S., R. 17 E., W.M.

G.9167  
 54631  
 75636  
 77556  
 T8925  
 80777  
 T8925

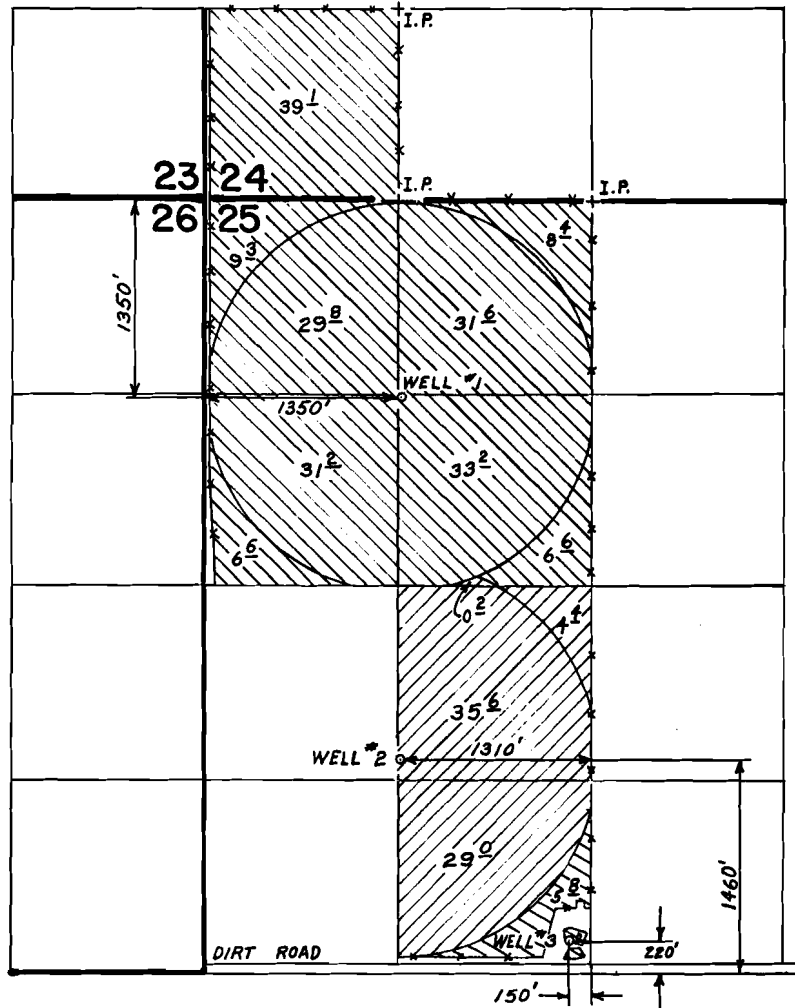

SCALE: 1" = 1320'

-  IRRIGATED from WELL #1
-  IRRIGATED from WELL #2
-  IRRIGATED from WELL #3

## FINAL PROOF SURVEY UNDER

Application No. G-10056. Permit No. G-9167.....  
 IN NAME OF

.....EARL L. GRASSMAN.....

Surveyed OCT. 29. 19.84, by LESLIE OLSON..