


T.26S.,R.18E.,W.M.

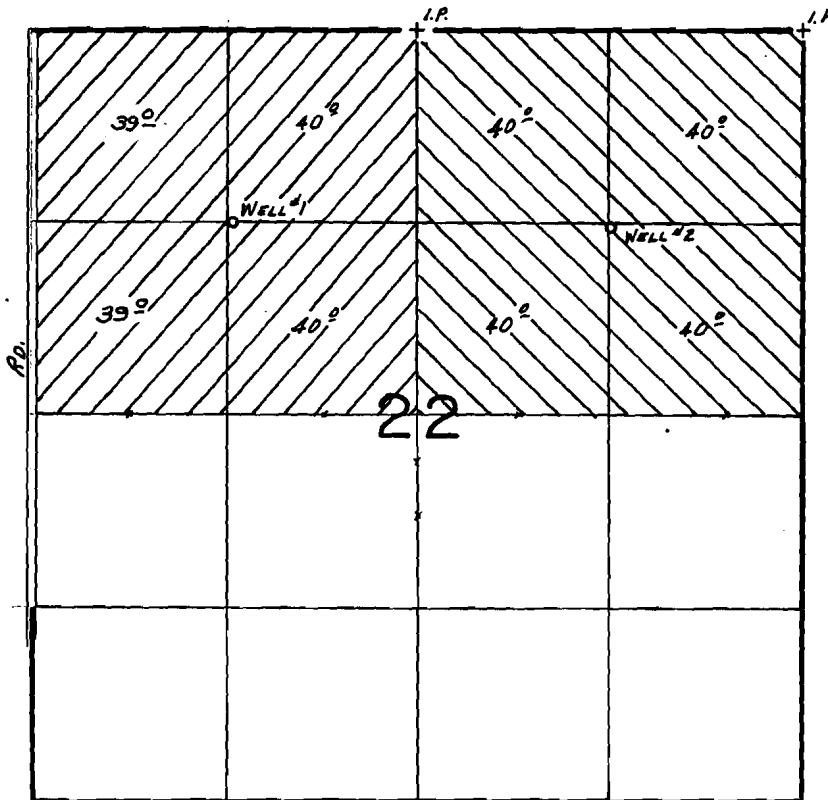

WELLS LOC.: #1-1320 S. & 1200 N., #2-1340 S. & 1340 E., BOTH FROM N. 1/4 COR. SEC. 22

 Well no.1
 Well no.2

SCALE: 1" = 1320'

FINAL PROOF SURVEY UNDER

Application No. G-9819. Permit No. G-9064....
IN NAME OF

.....GOLDEN RULE FARMS, INC.....

Surveyed Sept..17... 19.85, by B.W. BISHOP.....