


T. 12 S. R. 2 & 3 W. W.M.

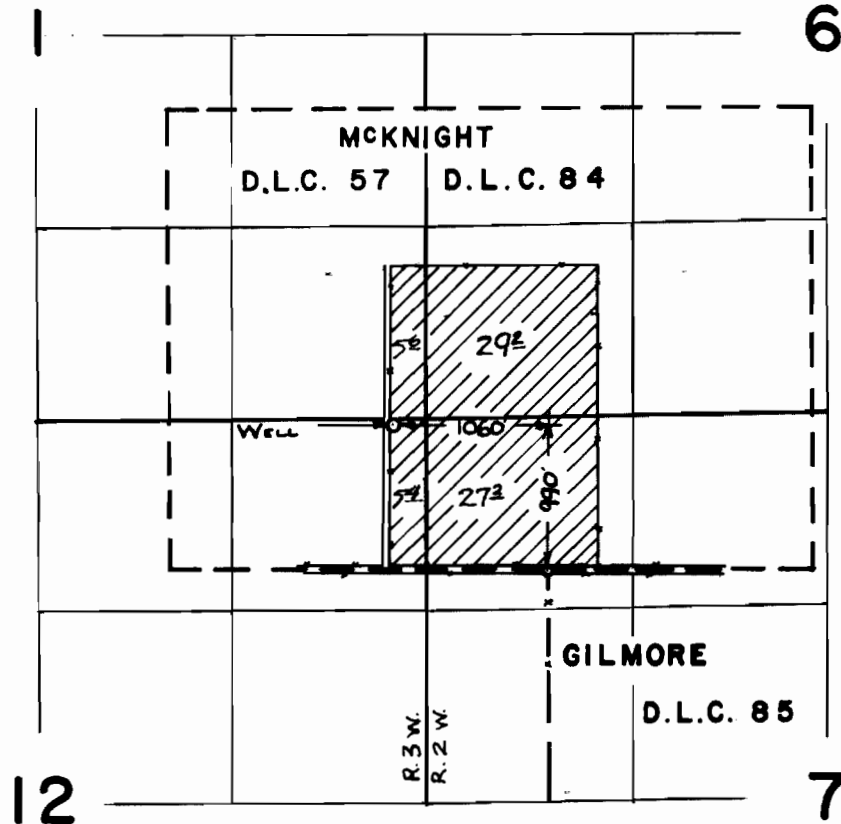

FINAL PROOF SURVEY
UNDER

Application No. G. 2566. Permit No. G. 2375.
IN NAME OF

.....**GLENN L. JACKSON**.....

Surveyed 18 AUG. 1969, by W. J. RUPPERT