


T.5&6S. R.1W. W.M.

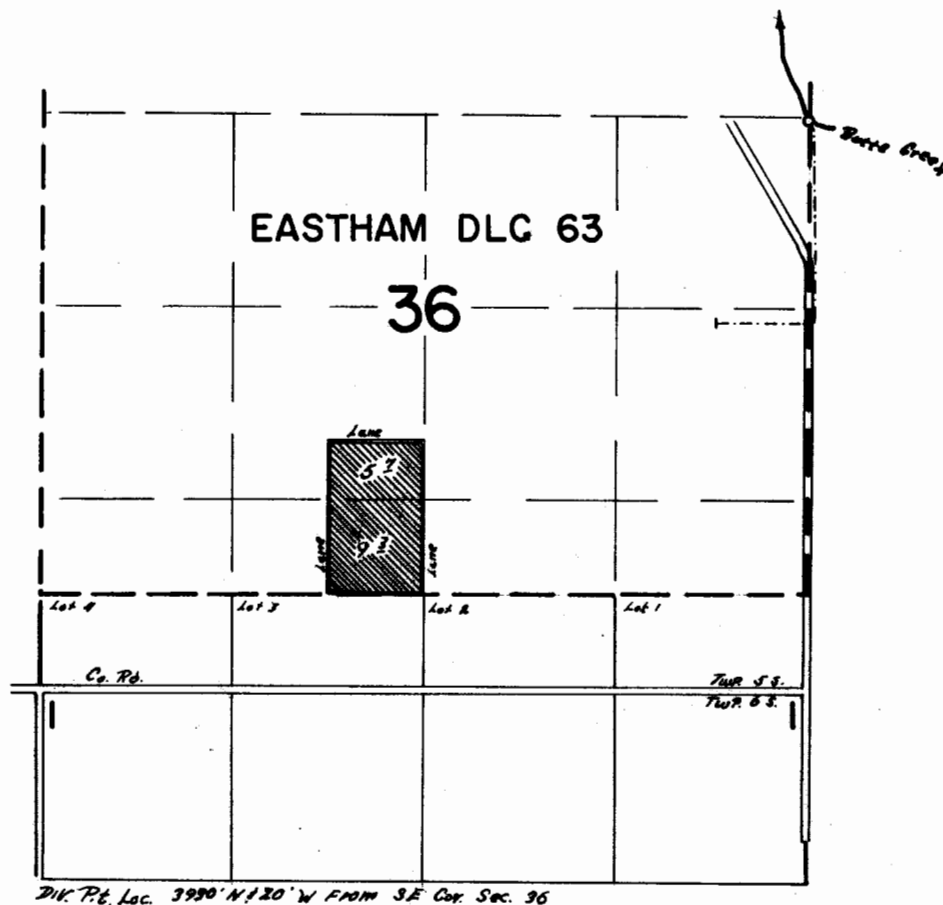

FINAL PROOF SURVEY
UNDER

Application No. 44355 Permit No. 3316
IN NAME OF

LOUIS BERNING

Surveyed Aug. 16 1972, by R. B. Mucken