


T. 8 S., R. 1 W., W.M.

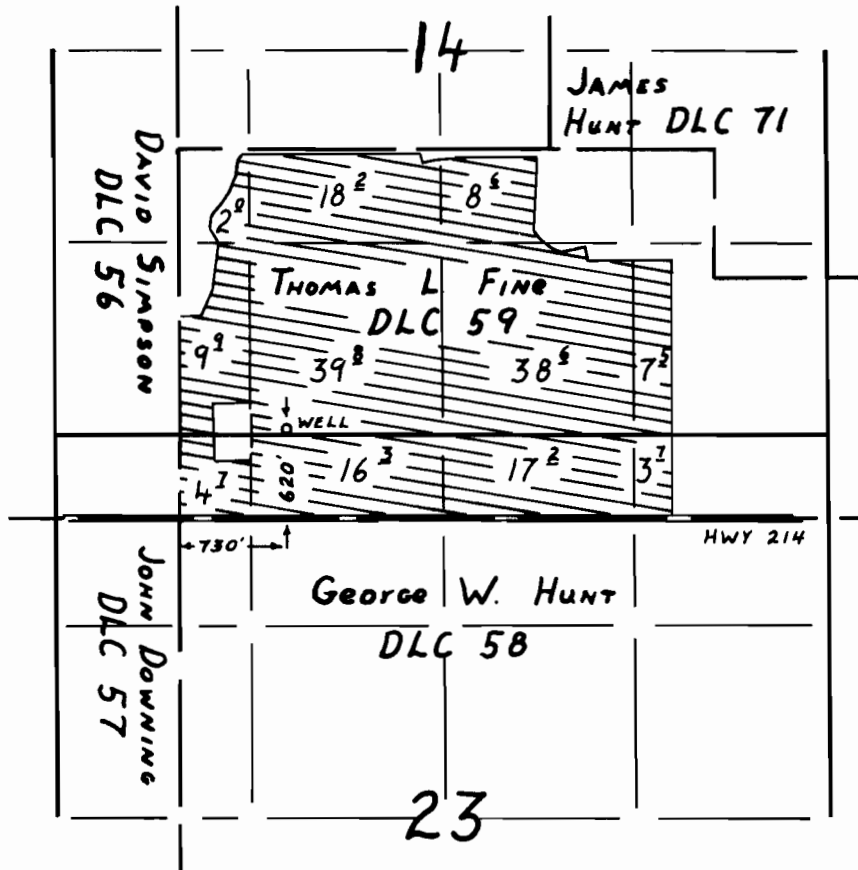

See T-8061
Change 55

FINAL PROOF SURVEY

UNDER

Application No. G-11541 Permit No. G-10629
IN NAME OF

ANTHONY T. HENDRICKS

Surveyed MARCH 19, 1991, by R.W. Klassen