


T. 8 S., R. 25 E., W. M.

RECEIVED

MAY - 2 1997

WATER RESOURCES DEPT.
SALEM, OREGON

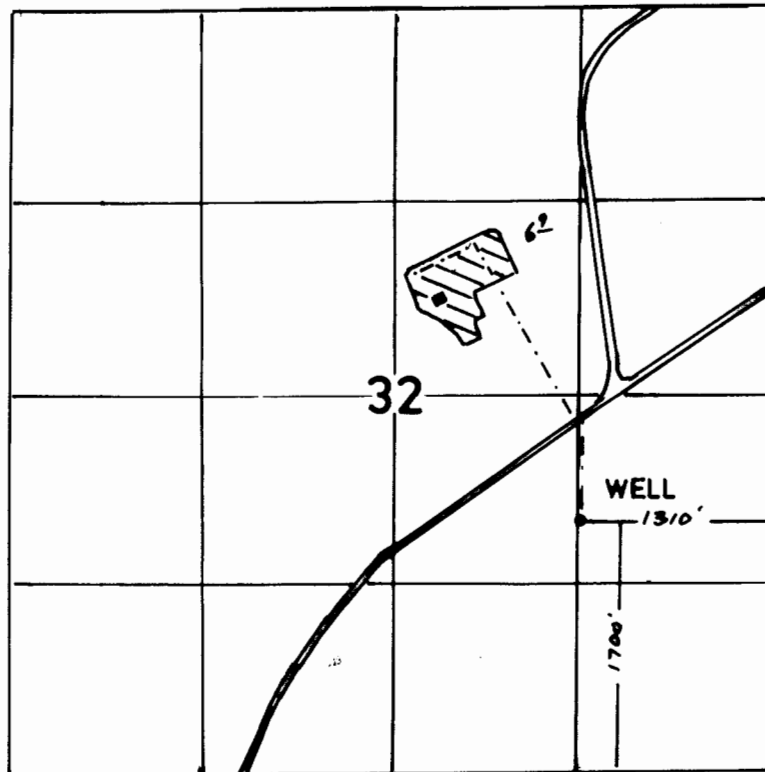

N

1" = 1320'

FINAL PROOF SURVEY UNDER

Application No. G-10048. Permit No. G-9951.....
IN NAME OF

.....
Surveyed MAY. 12.... 1995..., by J. MILLER.....