



RECEIVED

DEC 14 1996

WATER RESOURCES DIVISION
SALEM, OREGON

FINAL PROOF SURVEY MAP
IN THE NAME OF **CARL BARRON**
SECTIONS 11 AND 12, TOWNSHIP 22, SOUTH, RANGE 6 WEST, W.M.

APPLICATION S-71327 PERMIT 51900

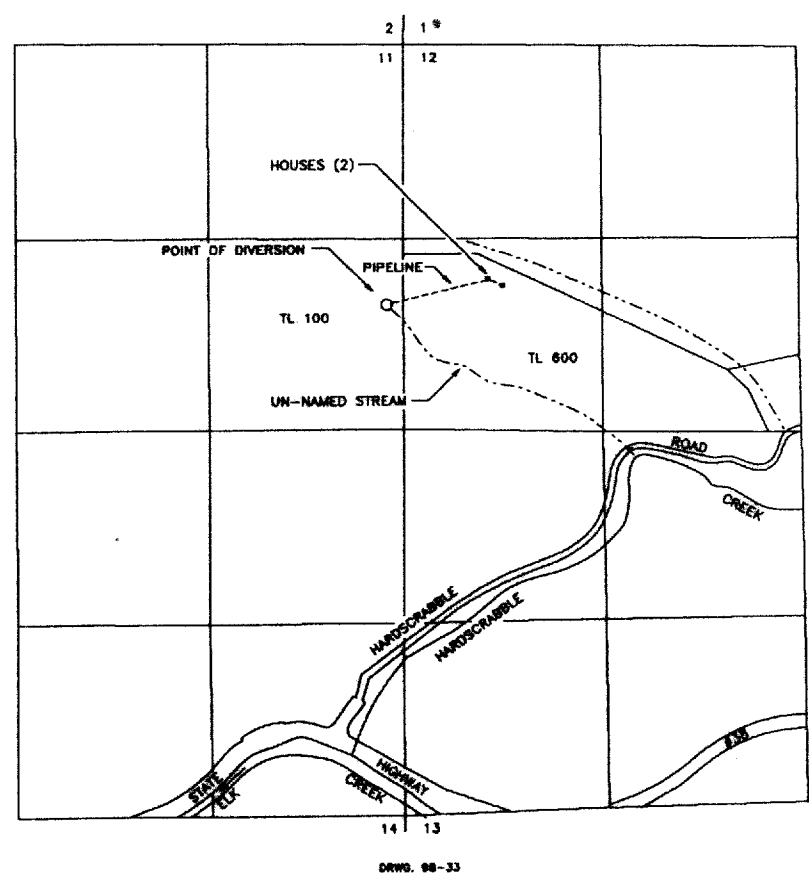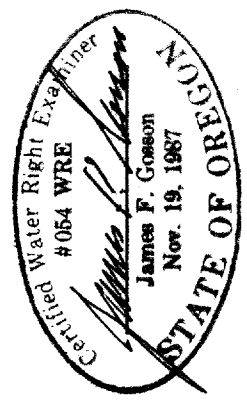

POINT OF DIVERSION IS LOCATED 1780 FEET SOUTH AND 120 FEET WEST FROM THE NORTHWEST CORNER OF SECTION 12, BEING WITHIN THE SE 1/4 OF THE NE 1/4 OF SECTION 11.

THE PURPOSE OF THIS MAP IS TO IDENTIFY THE LOCATION OF THE WATER RIGHT. IT IS NOT INTENDED TO PROVIDE INFORMATION RELATIVE TO THE LOCATION OF PROPERTY OWNERSHIP BOUNDARY LINES.

RECEIVED



FINAL PROOF SURVEY MAP
IN THE NAME OF DANIEL R. ASH

SEP 17 1999

WATER RESOURCES DEPT.
SALEM, OREGON

SECTIONS 12, TOWNSHIP 22, SOUTH, RANGE 6 WEST, W.M.

APPLICATION S-71327 PERMIT 51900

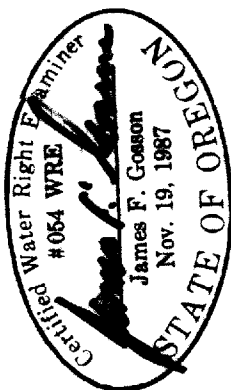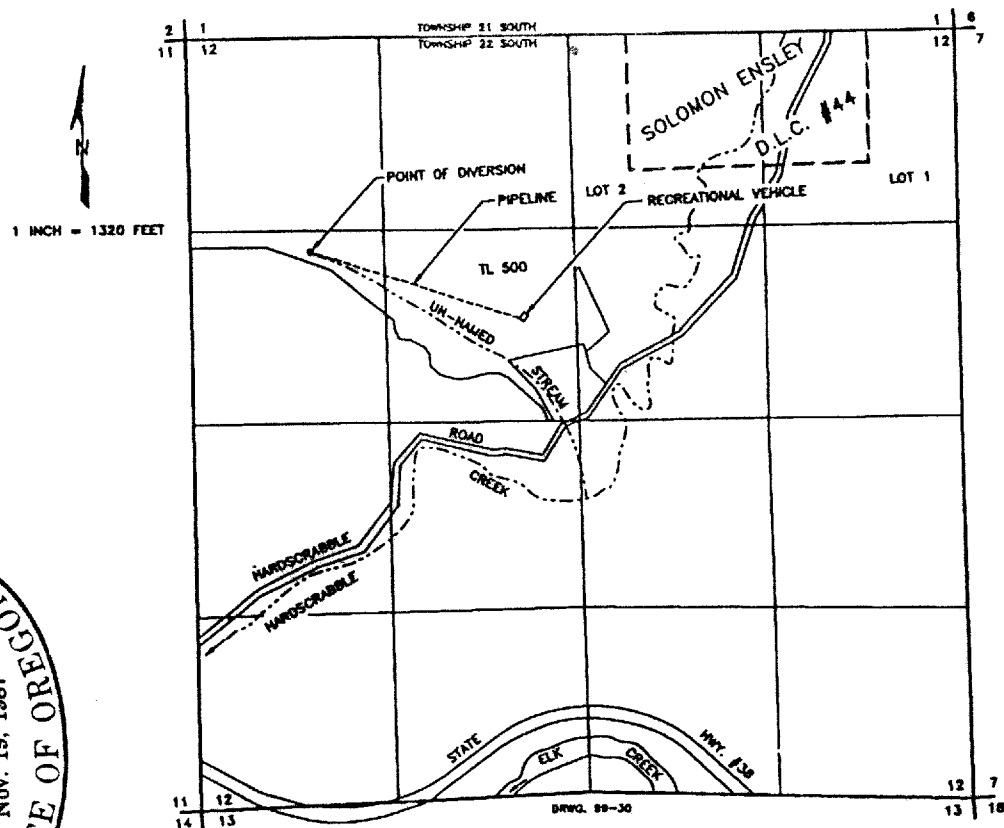

THE POINT OF DIVERSION IS LOCATED 1540 FEET SOUTH AND 770 FEET EAST FROM THE NORTHWEST CORNER OF SECTION 12, BEING WITHIN THE SOUTHWEST 1/4 OF THE NORTHWEST 1/4 OF SECTION 12, TOWNSHIP 22 SOUTH, RANGE 6 WEST, W.M., DOUGLAS COUNTY.

THE PURPOSE OF THIS MAP IS TO IDENTIFY THE LOCATION OF THE WATER RIGHT. IT IS NOT INTENDED TO PROVIDE INFORMATION RELATIVE TO THE LOCATION OF PROPERTY OWNERSHIP BOUNDARY LINES.