


SECTION 16, T.2 N., R.3 W., W.M.

WASHINGTON COUNTY, OREGON

9 10

16 15

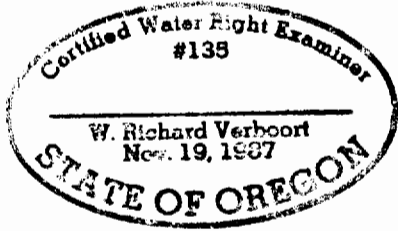

SCALE: 1"=400'

MAP BASE:
COUNTY TAX MAP &
1991 WAC SCALED PHOTO

PREPERATION OF THIS MAP IS FOR THE
PURPOSE OF IDENTIFYING THE LOCATION OF
THE WATER RIGHT ONLY. THERE IS NO INTENT
TO PROVIDE DIMENSIONS OR LOCATION OF
PROPERTY OWNERSHIP LINES.

T.L. 600

6.0 Ac

CURRENT P.O.D.

ORIGINAL P.O.D.

200'
150'

1290'

1320'

FINAL PROOF SURVEY

UNDER T-6876

SURVEYED JUNE 6, 2000

VERBOORT ENGINEERING

AGRICULTURE · CIVIL · WATER RESOURCES
HILLSBORO, OREGON

RECEIVED

JUN 27 2000

	by	date
designed	WRV	6/06/00
drawn	JER	6/06/00
checked	WRV	6/06/00
drawing no.	00-A-09	
sheet no.	1 / 1	

GUTMANN NURSERIES INC.

19131 N.W. DAIRY CREEK ROAD
NORTH PLAINS, OR 97133

WATER RESOURCES DEPT.
SALEM, OREGON

N

T. 2 N., R. 3 W.

Washington County Oregon

Edgar Leming

Scale 400 ft. to 1 inch

North-east Corner
S.B. Rafferty D.C.

7.5

5.5

W

1/4 Sec.

Sec. 22 S. 23

Sec. 27 S. 26

To be irrigated

26

27.5

To be irrigated

East Fork of Dirty Creek

S

App. No. 15134

Per. No. 11068

