

TRANSFER APPLICATION MAP

APPLICATION No. T-9595 PERMIT No. G-9821


Applicant: Robert & Jean Shepherd
2110 6th Ave W
Vale, OR 97918

SCALE : 1" = 400'

T17S, R44E, WM

1/4

C1/4 COR.
SEC.20

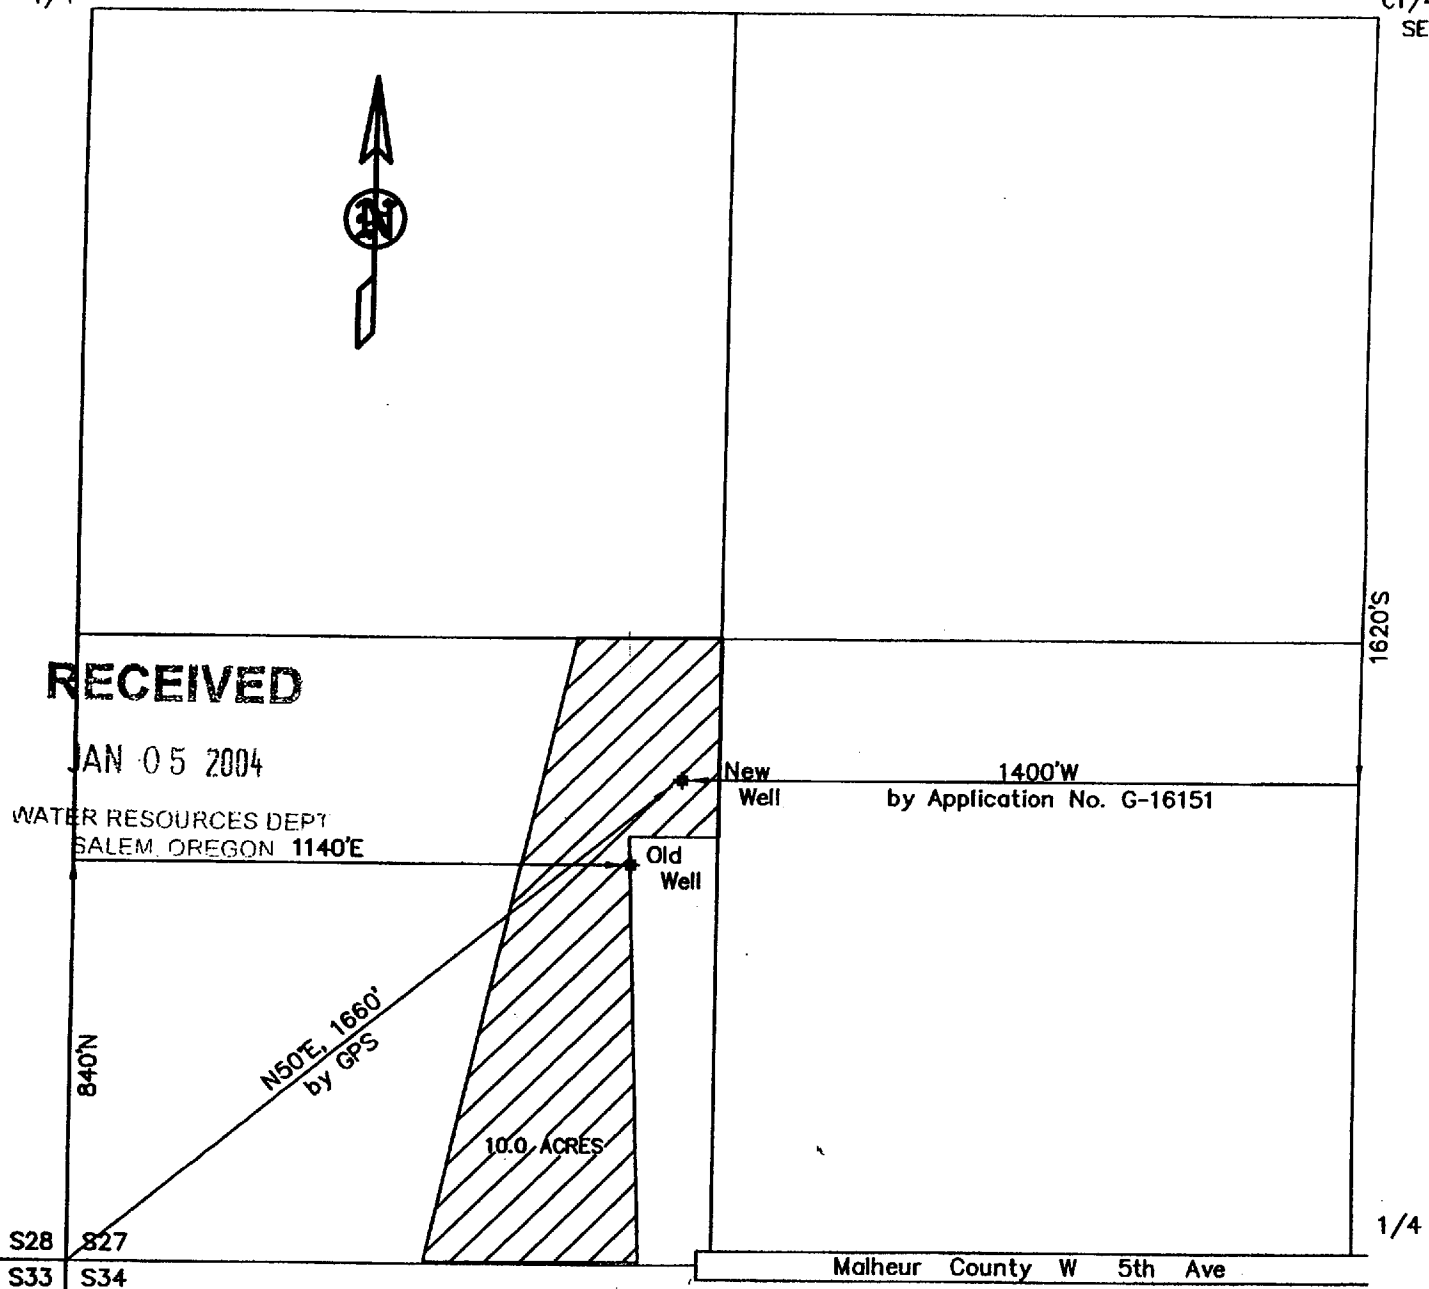

This map is for the purpose of identifying the location of the water right only and has no intent to provide dimensions or location of property ownership lines.

T-9595