


T. 5 S. R. 1 W. W.M.

RECEIVED


MAY 27 1989



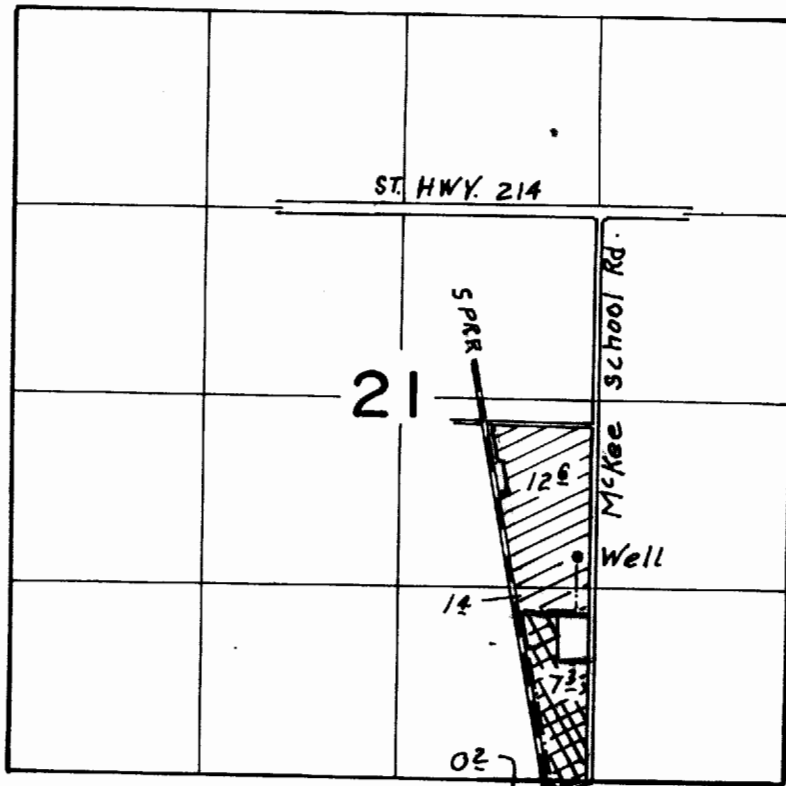

Scale
4" = 1 Mi.

Well loc. 1530' N & 1430' W from SE Cor. Sec. 21

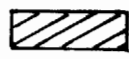 Ag. Use


 Irrig.

FINAL PROOF SURVEY UNDER

Transfer No. T-7632
Application No. G-13491 Permit No. G-121.67. & T-7755
IN NAME OF

BOB FESSLER

Surveyed April 26 1999, by

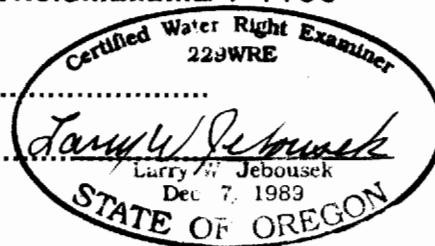

THIS MAP WAS PREPARED FOR THE PURPOSE OF IDENTIFYING THE LOCATION OF A WATER RIGHT ONLY AND IS NOT INTENDED TO PROVIDE LEGAL DIMENSIONS OR LOCATION OF PROPERTY OWNERSHIP LINES.

WAC -92 7C-6