


FINAL PROOF SURVEY

SECTION 14,
T. 40 S., R. 14 W., W.M.
CURRY COUNTY, OREGON

RECEIVED

FEB 1 1996
WATER RESOURCES DEPT.
SALEM, OREGON

APPLICATION NO. 70133 PERMIT NO. 51134
IN THE NAME OF EARL D. EDDY

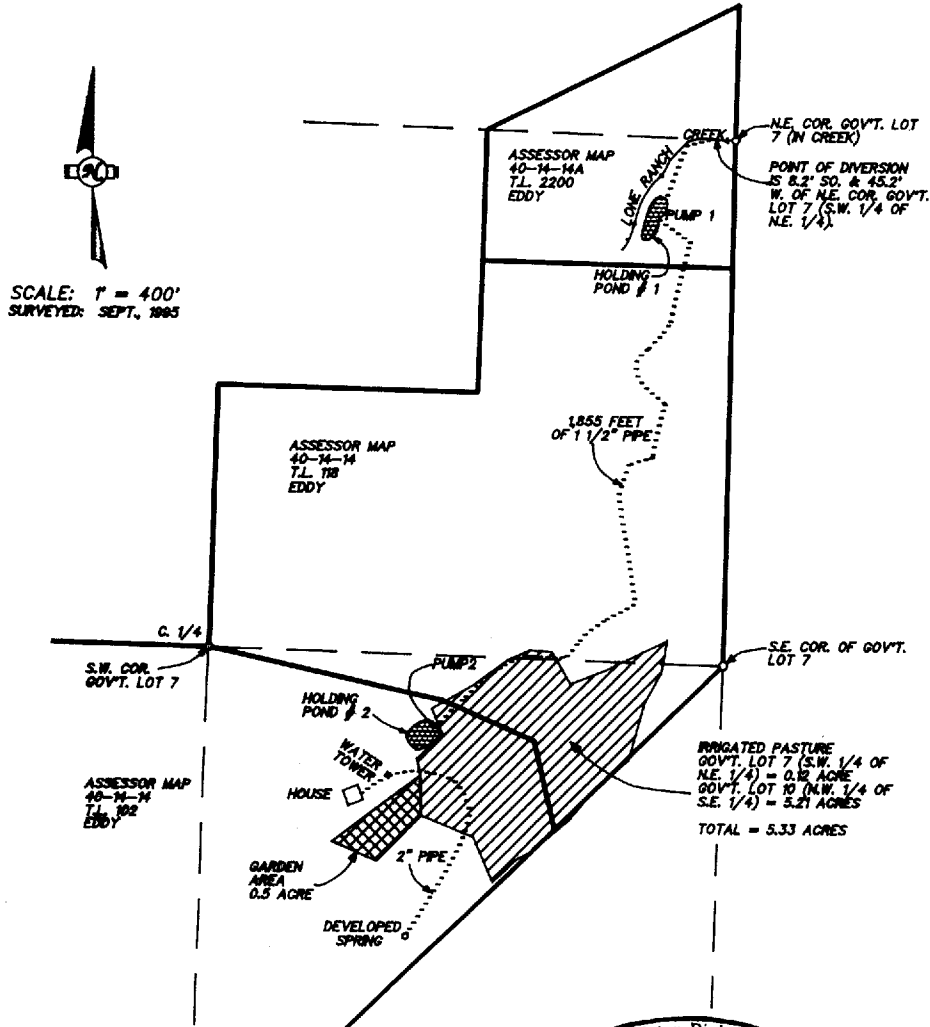

THE PREPARATION OF THIS MAP WAS
FOR THE PURPOSE OF IDENTIFYING THE
WATER RIGHT ONLY & HAS NO INTENT TO
PROVIDE DIMENSION OR LOCATION OF
PROPERTY OWNERSHIP LINES.

REILLY SMITH		BOUNDARY - CONSTRUCTION	
LAND SURVEYING		MAPPING - WATER RIGHTS	
P.O. BOX 7276 (CITY) 97415, OR 97415 Rm. 102-103 FAX 469-6328			
JOB # 35-85	DATE 9-5-95	PREPARED FOR MR. EARL EDDY	SHEET 1 OF 1
DESIGNED RLS	FOR 96215 ALDER RIDGE RD.	BROOKINGS, OR 97415	
CHECKED CRS	PH: (503) 469-6328		

T. 40 S., R. 14 W., W. M.


SECTION 14, GOV'T. LOTS 7 & 10

CURRY COUNTY, OREGON

RECEIVED

FEB 22 2000

**WATER RESOURCES DEPT.
SALEM, OREGON**

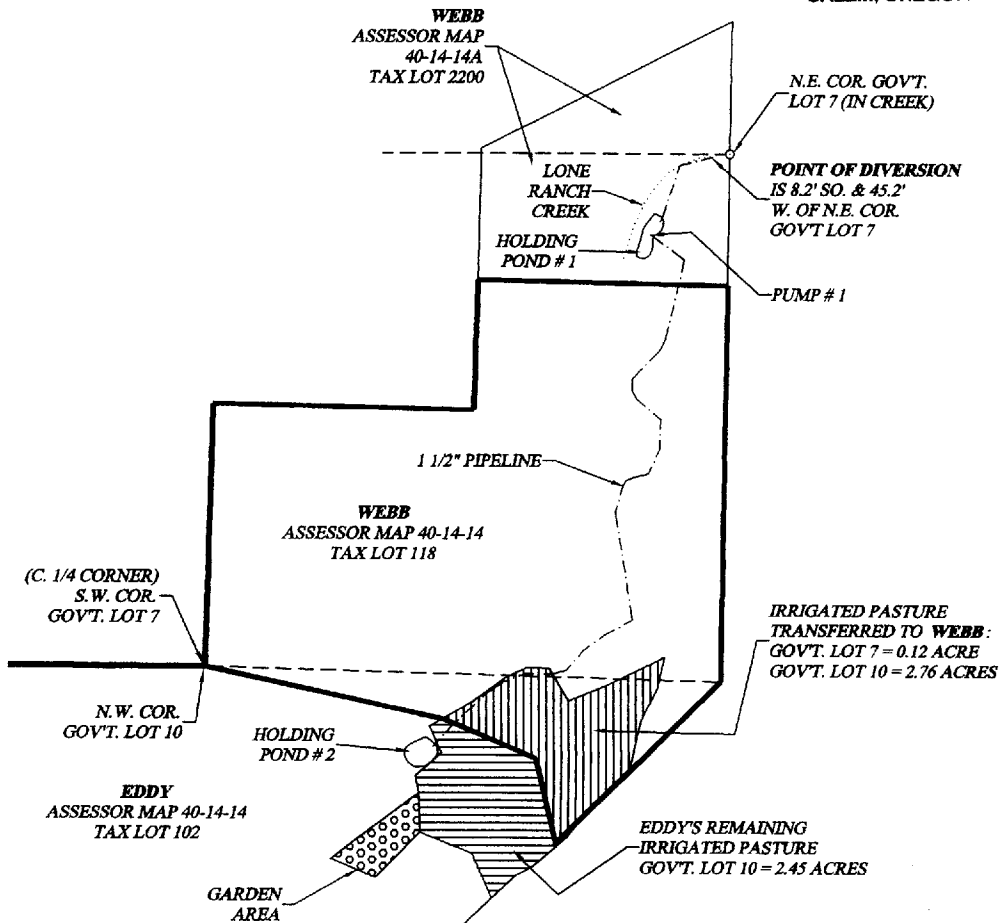

PERMANENT TRANSFER MAP

UNDER:

APPLICATION NO. 70133, PERMIT NO. 51134

**PORTION TRANSFERRED FROM EARL EDDY
TO: KEVIN L. & KAREN R. WEBB**

ORIGINALLY SURVEYED: SEPT. 1995

BY: REILY SMITH, C.W.R.E.


PORTION TRANSFERRED: CALCULATED FEB. 14, 2000

BY: REILY SMITH, C.W.R.E.

FINAL CLAIM OF BENEFICIAL USE PENDING APPROVAL

**THIS MAP IS FOR THE PURPOSE OF IDENTIFYING
THE LOCATION OF THE WATER RIGHT ONLY AND IS
NOT INTENDED TO PROVIDE LEGAL DIMENSIONS OR
LOCATIONS OF PROPERTY OWNERSHIP LINES.**

**Scale: 1" = 400'
Graphic Scale:**

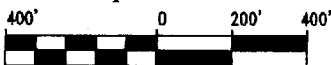

EXPIRES: JUNE 30, 2000

Reily Smith

Land Surveying

864 Jodee Ln. Brookings, OR. 97415

Ph: (541) 469-9166 Fax: (541) 469-7507

Job # 06-00

Date: Feb. 14, 2000

Drawn: R. H. Smith

File: EddyWH20.dwg

Clients:

**Kevin L. & Karen R. Webb
99315 Winchuck River Rd.
Brookings, OR. 97415**