
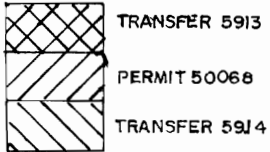


T. 30S., R. 4 W., W. M.

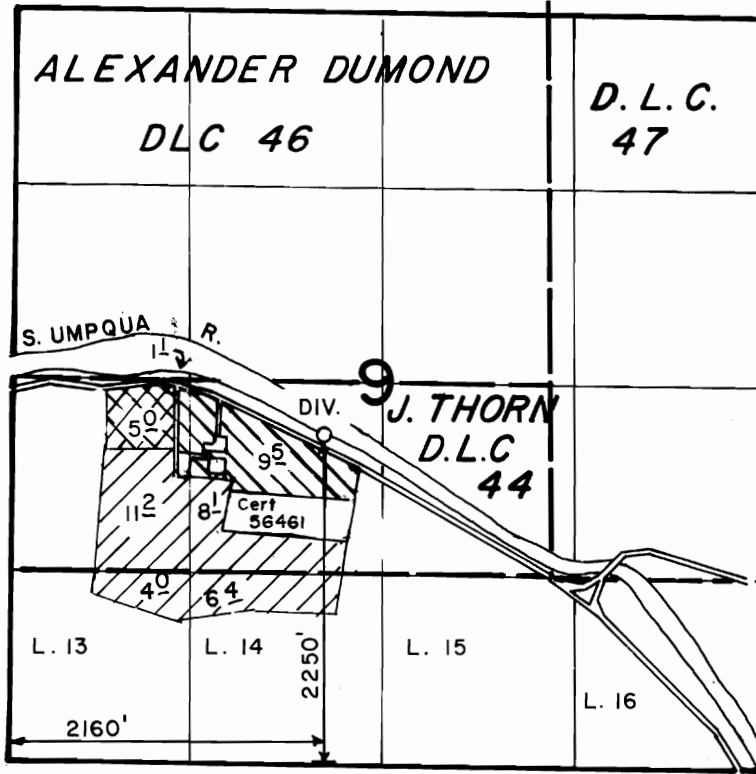

SCALE: 4" = 1 MILE

FINAL PROOF SURVEY UNDER

Application No 69016 Permit No 50068

TRANSFER NUMBERS T-5913 & T-5914

IN NAME OF

TOMMY M. AND NADEAN E. SMITH

Surveyed AUG. 11..... 1987., by J.M. SCHMORDE...

APRIL 24 1990 B S JAMES