FINAL PROOF SURVEY

UNDER

Application No. G-8956 Permit No. G-9178

IN NAME OF

Columbia Empire Farms - R2 Ranch

RECEIVED
APR 05 2004
WATER RESOURCES DEPT
SALEM, OREGON

T. 9S., R. 15E., W.M.

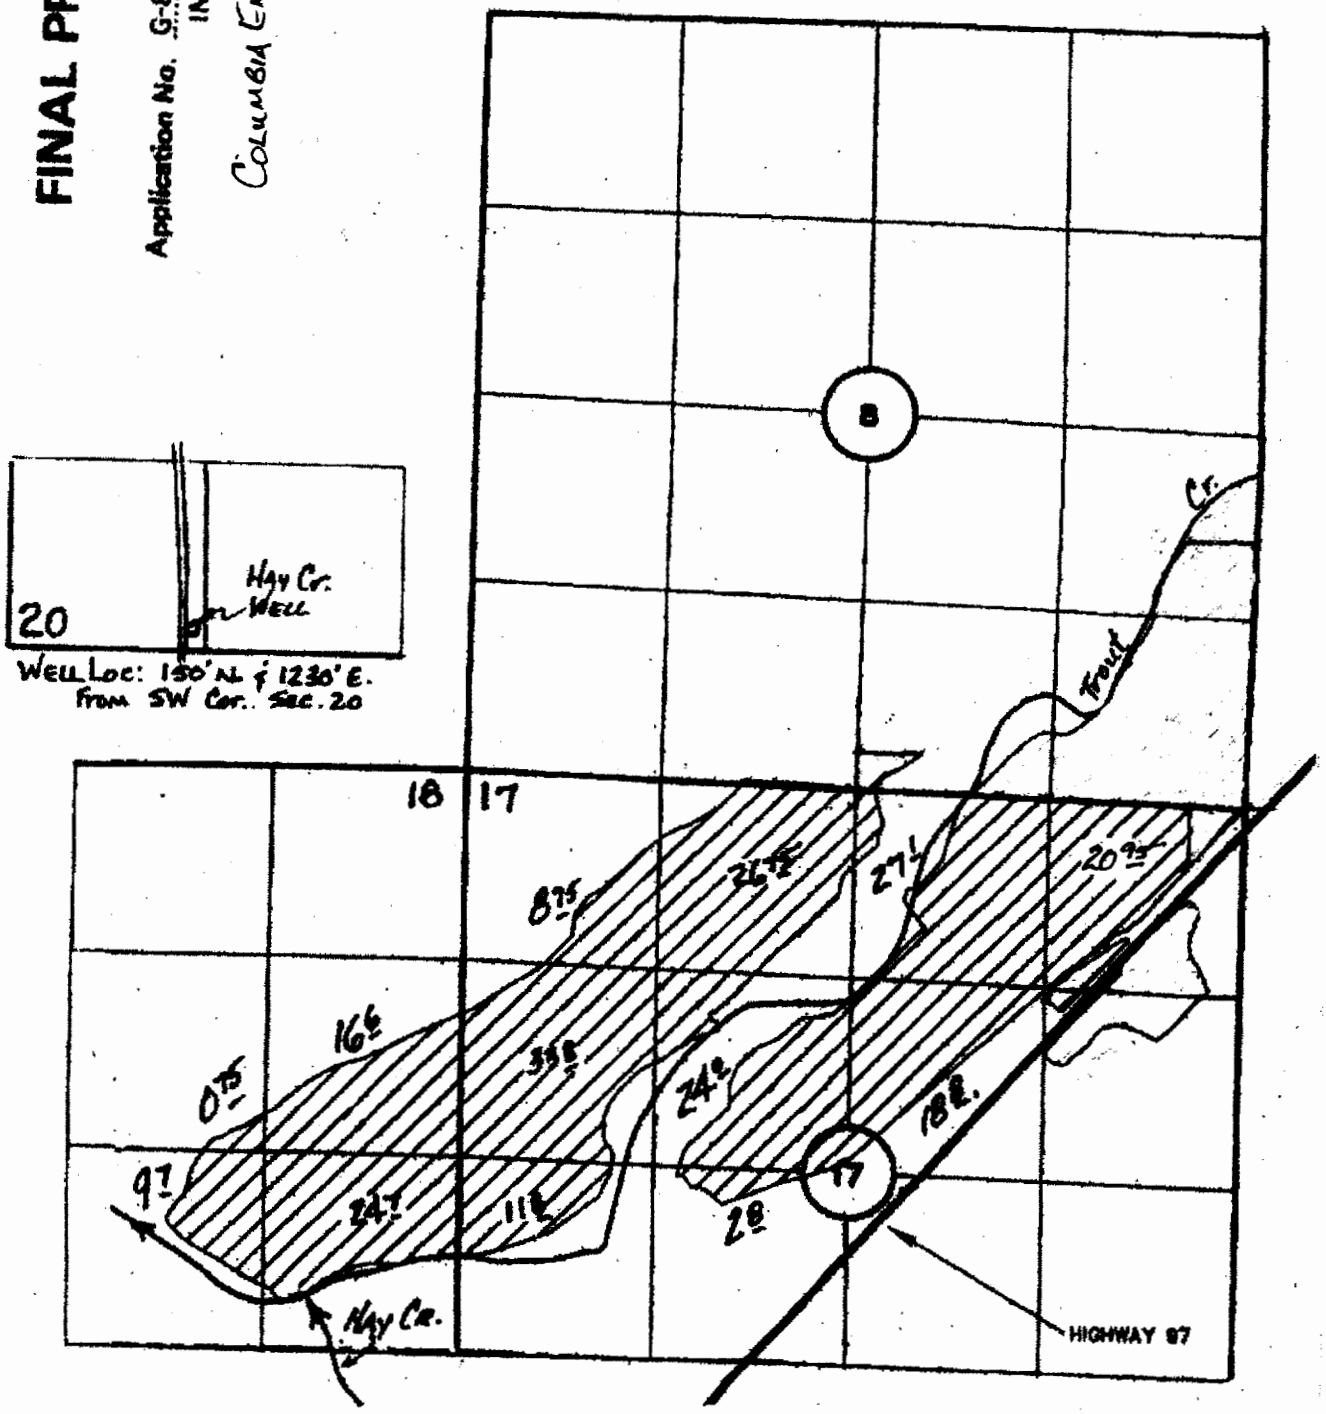

03/04