




Final Proof Survey

TOWNSHIP 12 SOUTH RANGE 1 WEST, W.M.

SCALE 1" = 1320 FT.

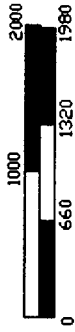

PREPARED BY
Walter L. Trimmer
 CWRE#332
 9/7/2003

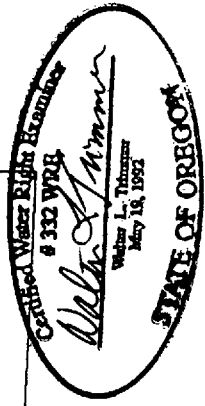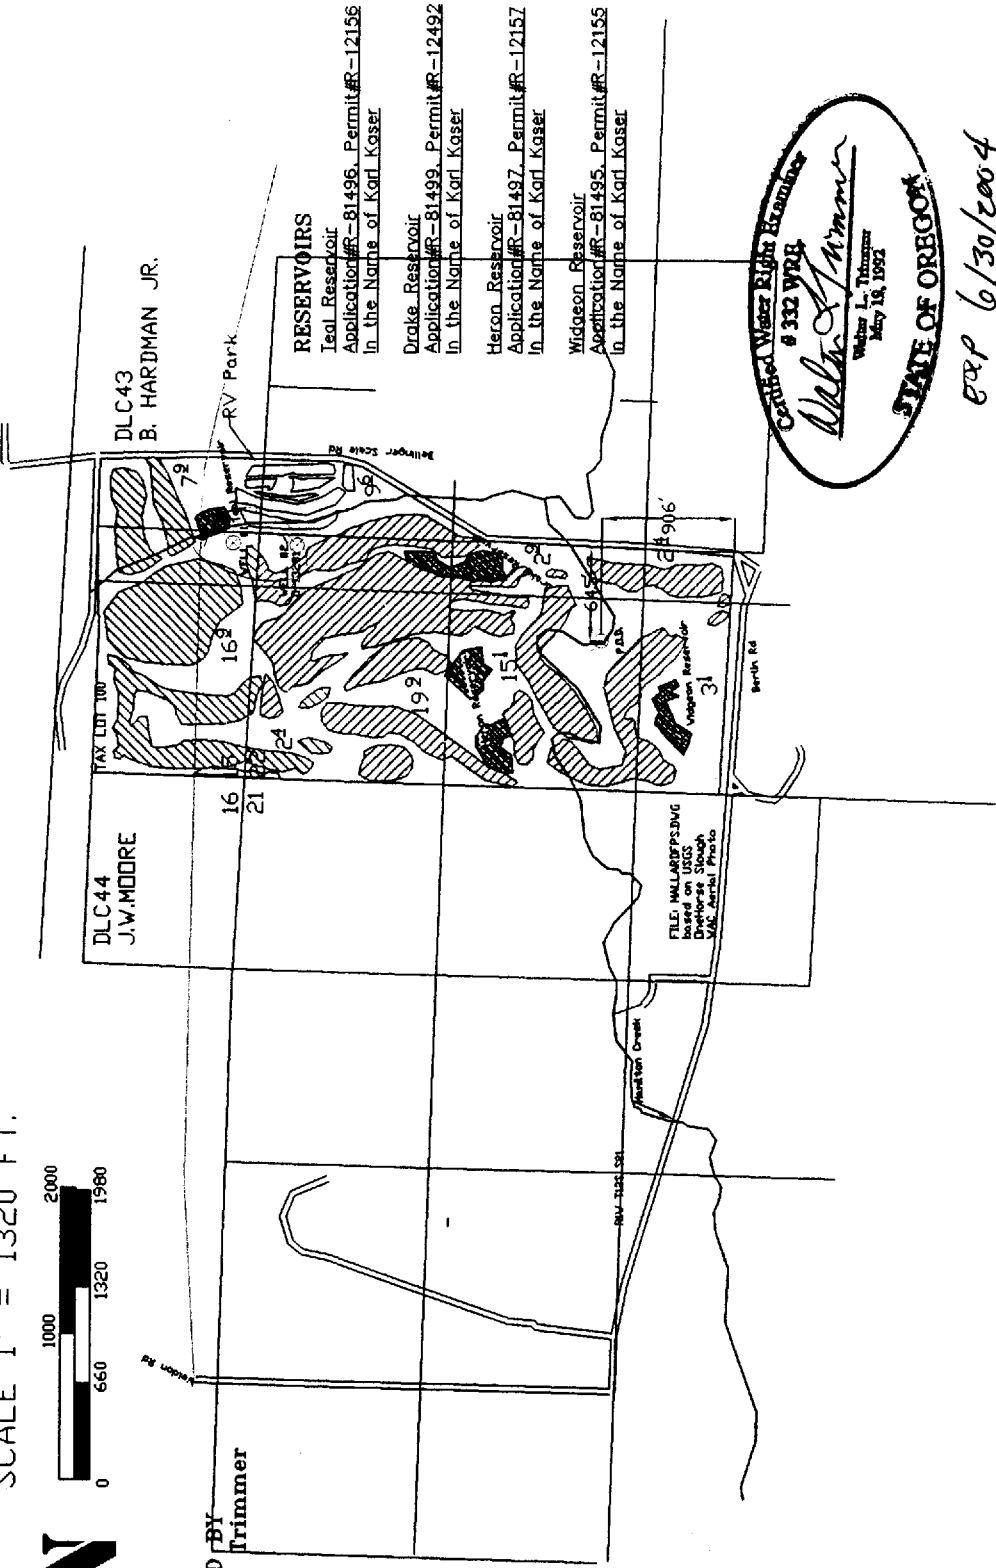

exp 6/30/2004

RECEIVED

SEP 15 2003

WATER RESOURCES DEPT.
 SALEM, OREGON