



Final Proof Survey TOWNSHIP 12 SOUTH RANGE 1 WEST, W.M.

SCALE 1" = 1320 FT.

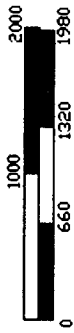

PREPARED BY
Walter L. Trimmer
CWRE#332
9/7/2003

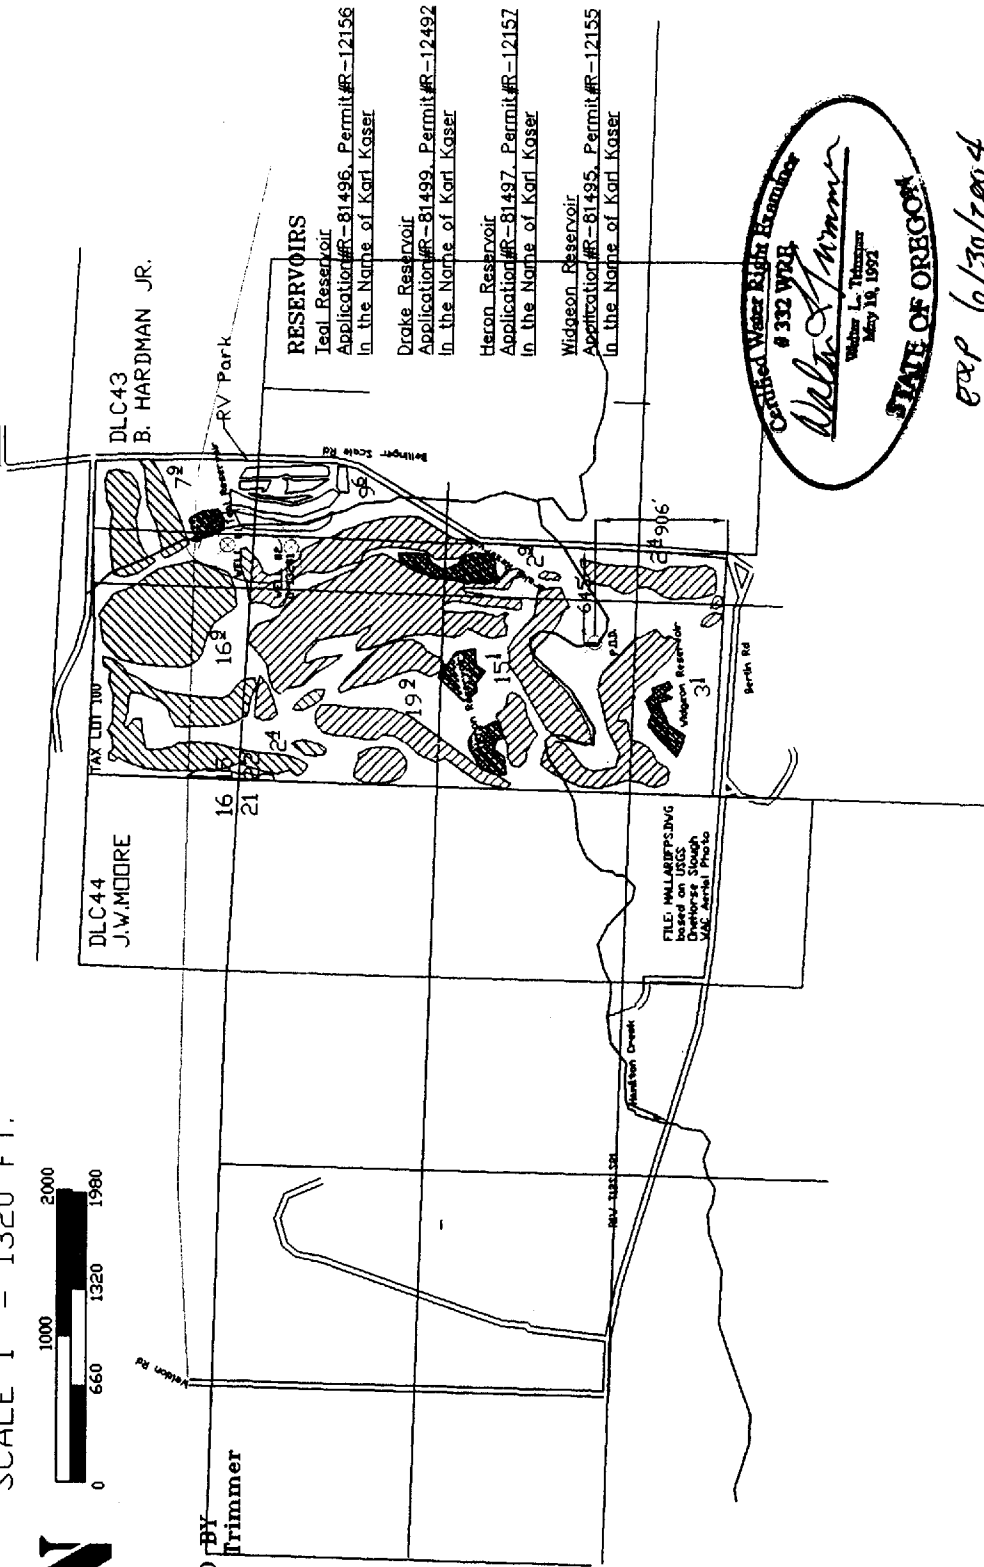

 # 332 WRR
Walter L. Trimmer
 Walter L. Trimmer
 May 18, 1992
 STATE OF OREGON

exp 6/30/2004

RECEIVED

SEP 15 2003

WATER RESOURCES DEPT.
SALEM, OREGON