

UNITED STATES
DEPARTMENT OF THE INTERIOR
BUREAU OF LAND MANAGEMENT

SECTION 32
SE 1/4 SE 1/4


Oregon State Water Filings

400 ft. N 4
950 ft. E of
Sw

TOWNSHIP 23 S, RANGE 36 E, W. M.

Cold Spr. 01-4664

North ↑

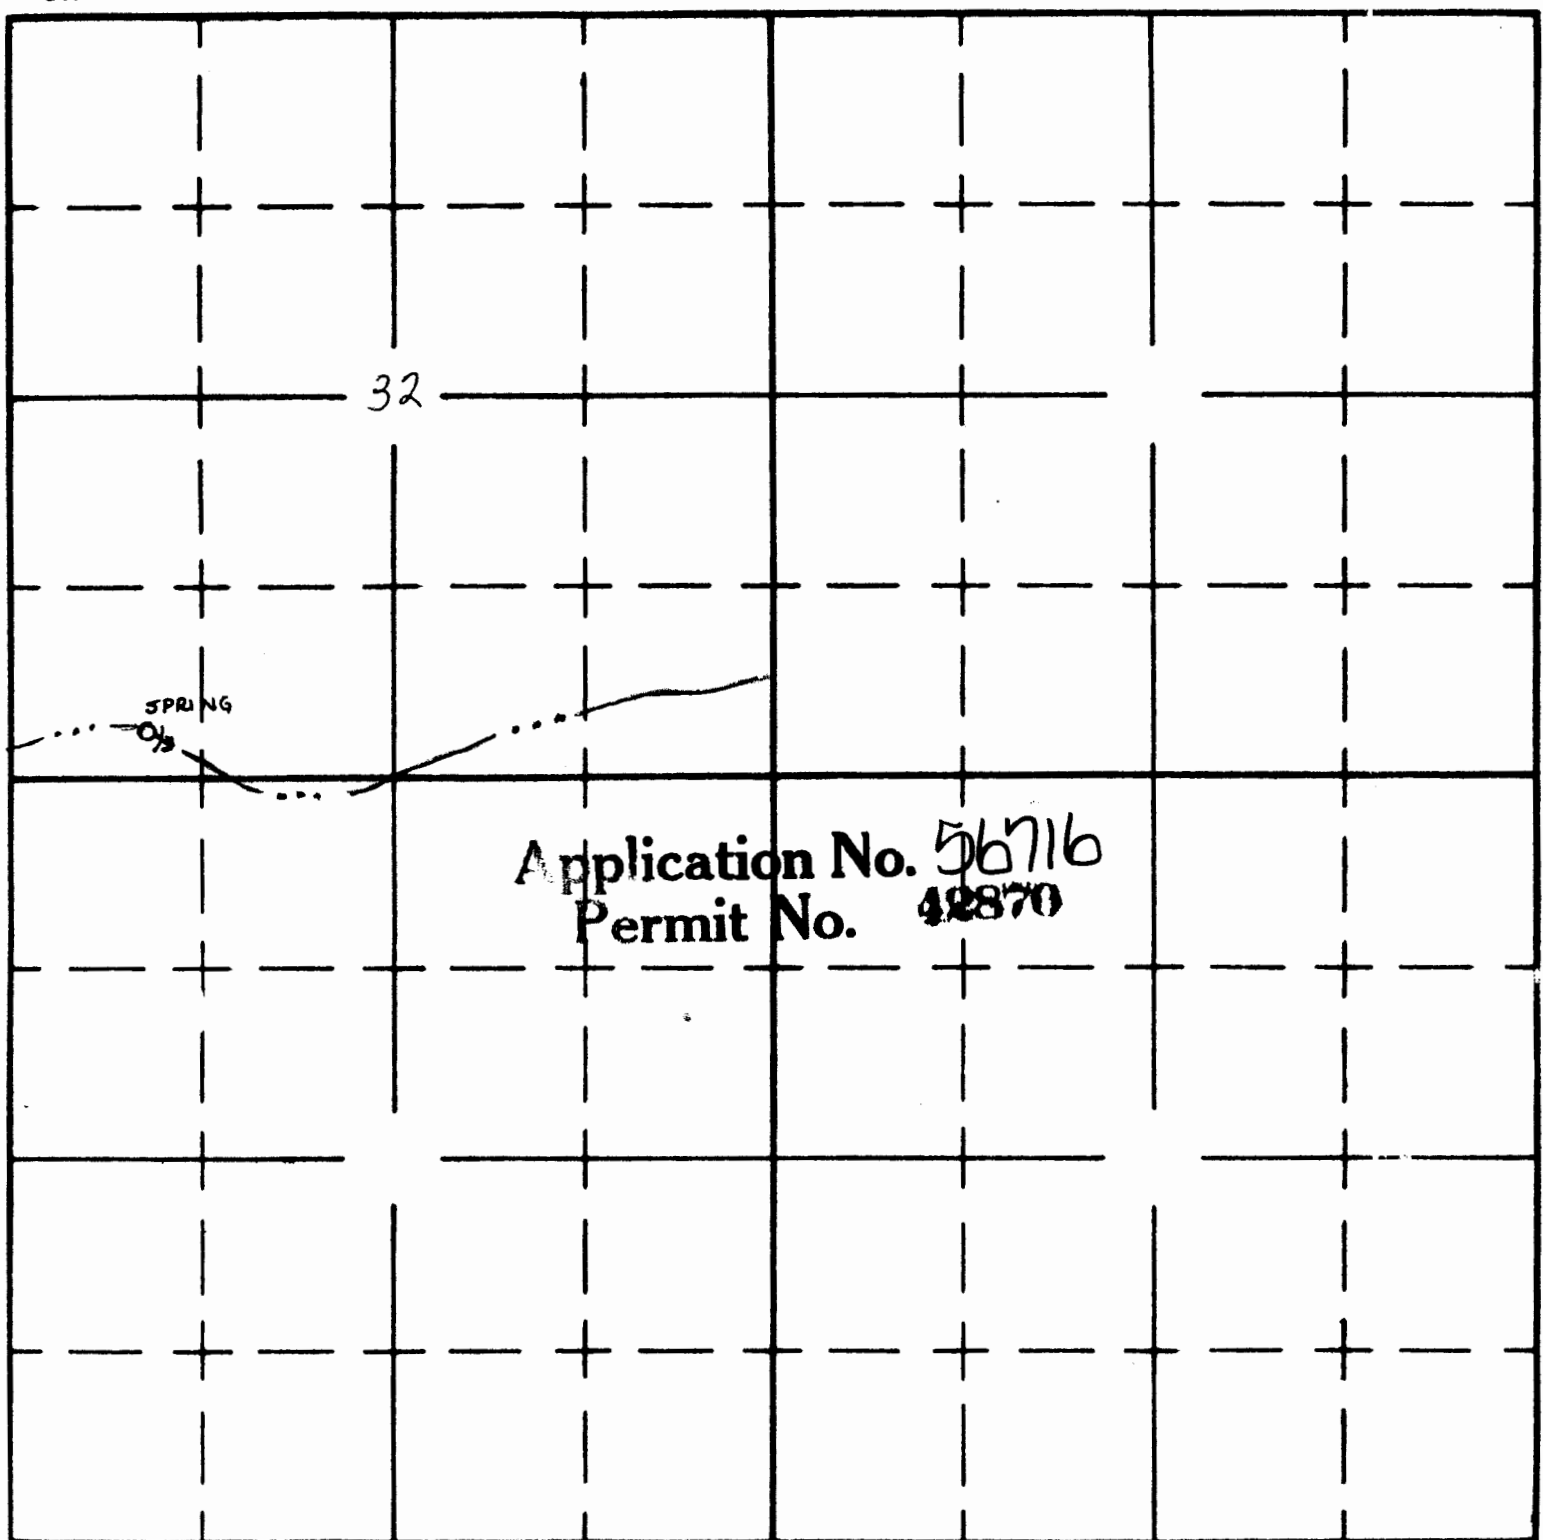

South

APPLICATION No. 56716
PERMIT No.