


25
NW SE

11-6019
4 3535

TOWNSHIP 34 S, RANGE 33 E, W. M.

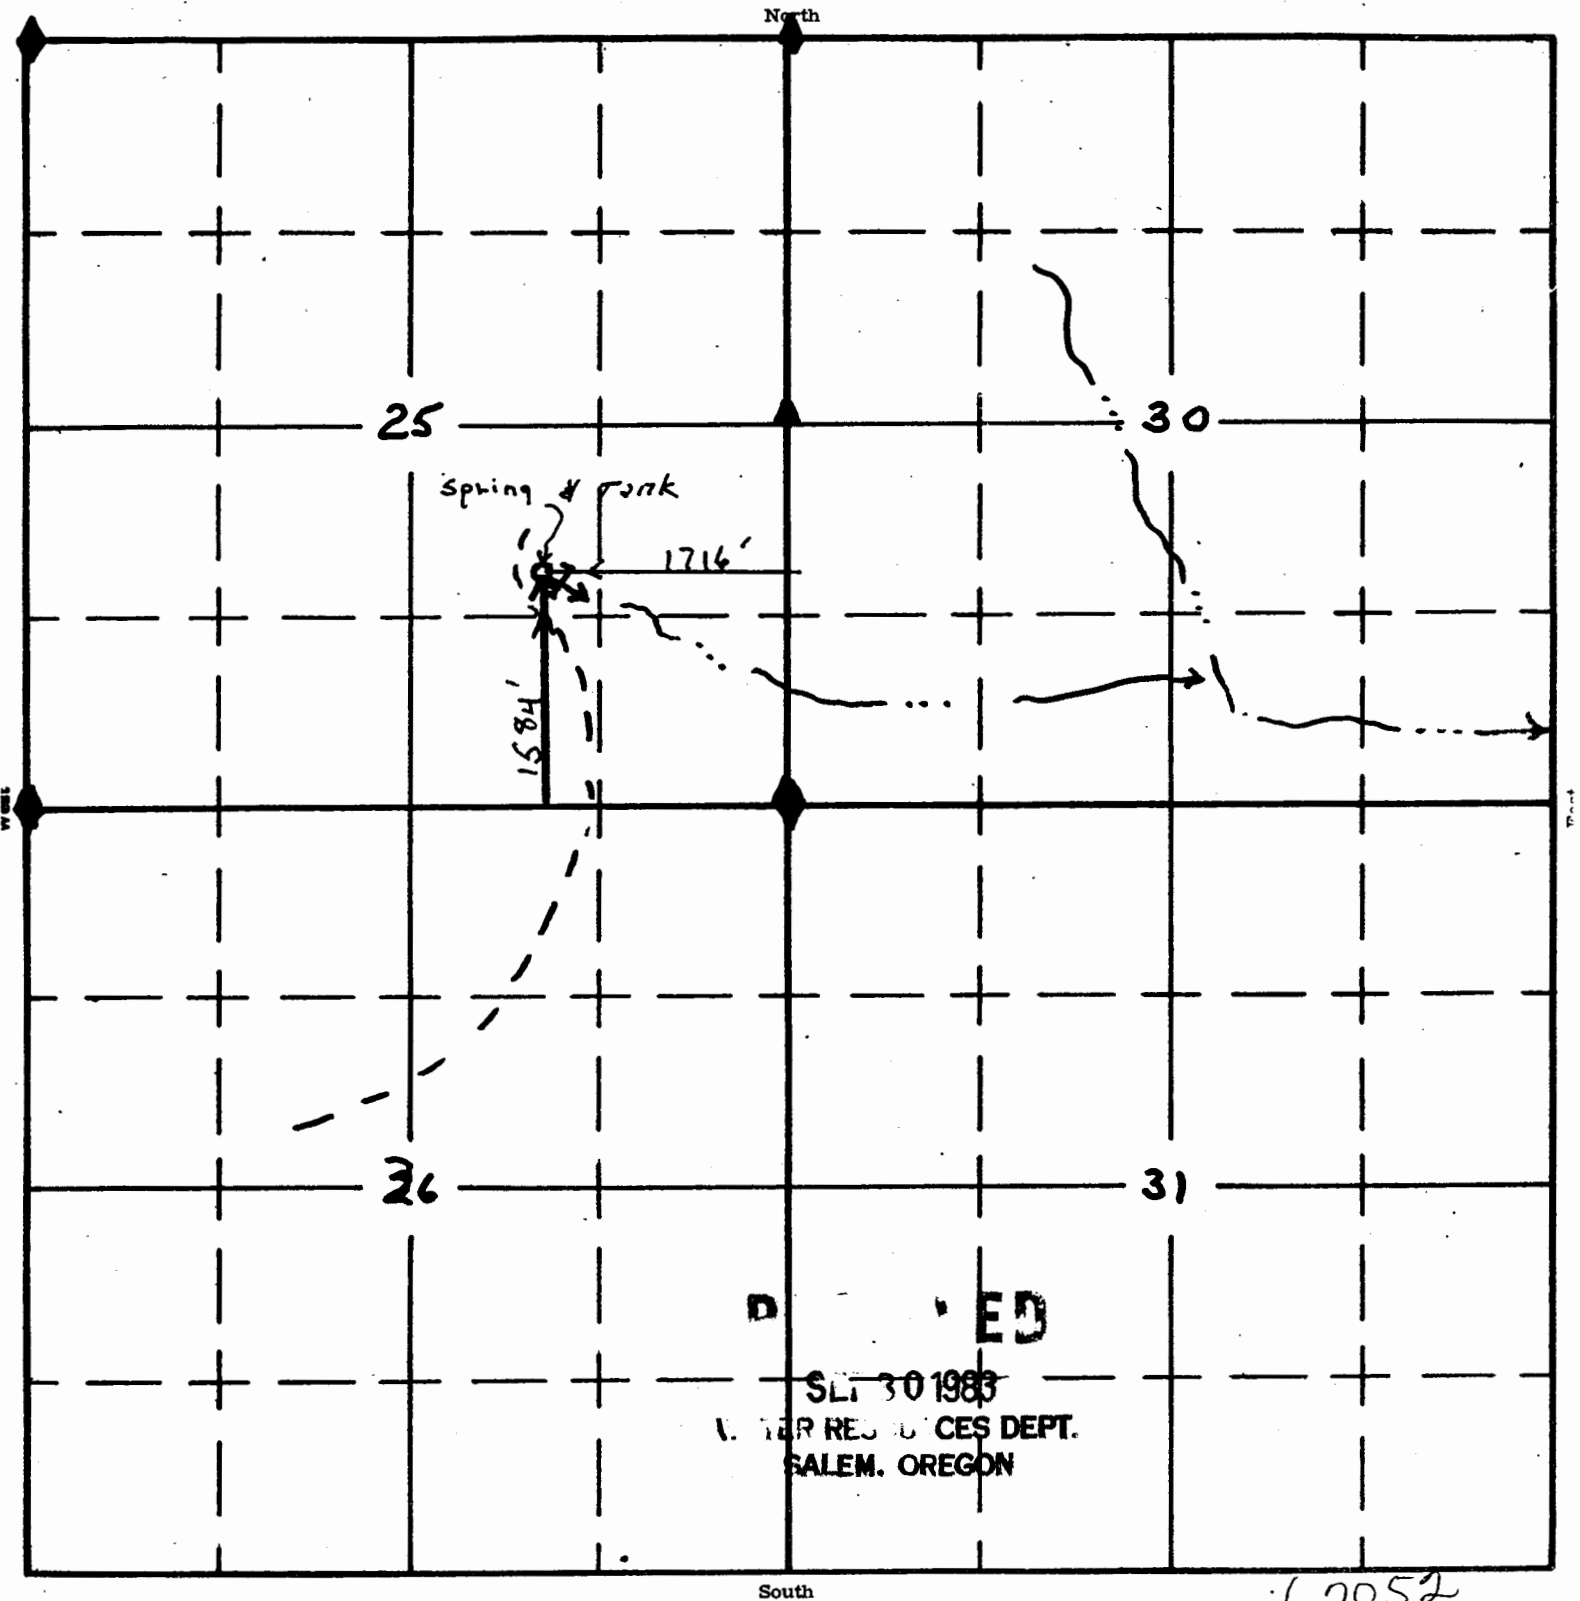

67052
Application No.
Permit No. 49712