

R2W W.M.

8

9

17

16



T6S

DLC 66

DLC 67

2,349'


2,110'

1,920'


1,710'

Irrigated Area- 0.35 Ac

7.67 Ac

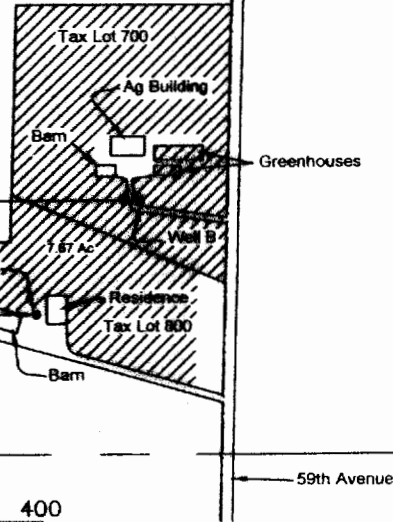

59th Avenue

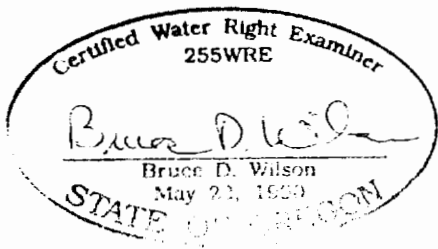

400 0 400
SCALE IN FEET

FINAL PROOF MAP

FOR

Application No. G-14891, Permit No. G-13707
in the name of

Hollis D. and Georgia L. Watson

NOTE: THIS MAP WAS PREPARED FOR THE PURPOSE OF IDENTIFYING THE LOCATION OF A WATER RIGHT ONLY AND IS NOT INTENDED TO PROVIDE LEGAL DIMENSIONS OR LOCATION OF PROPERTY OWNERSHIP LINES.