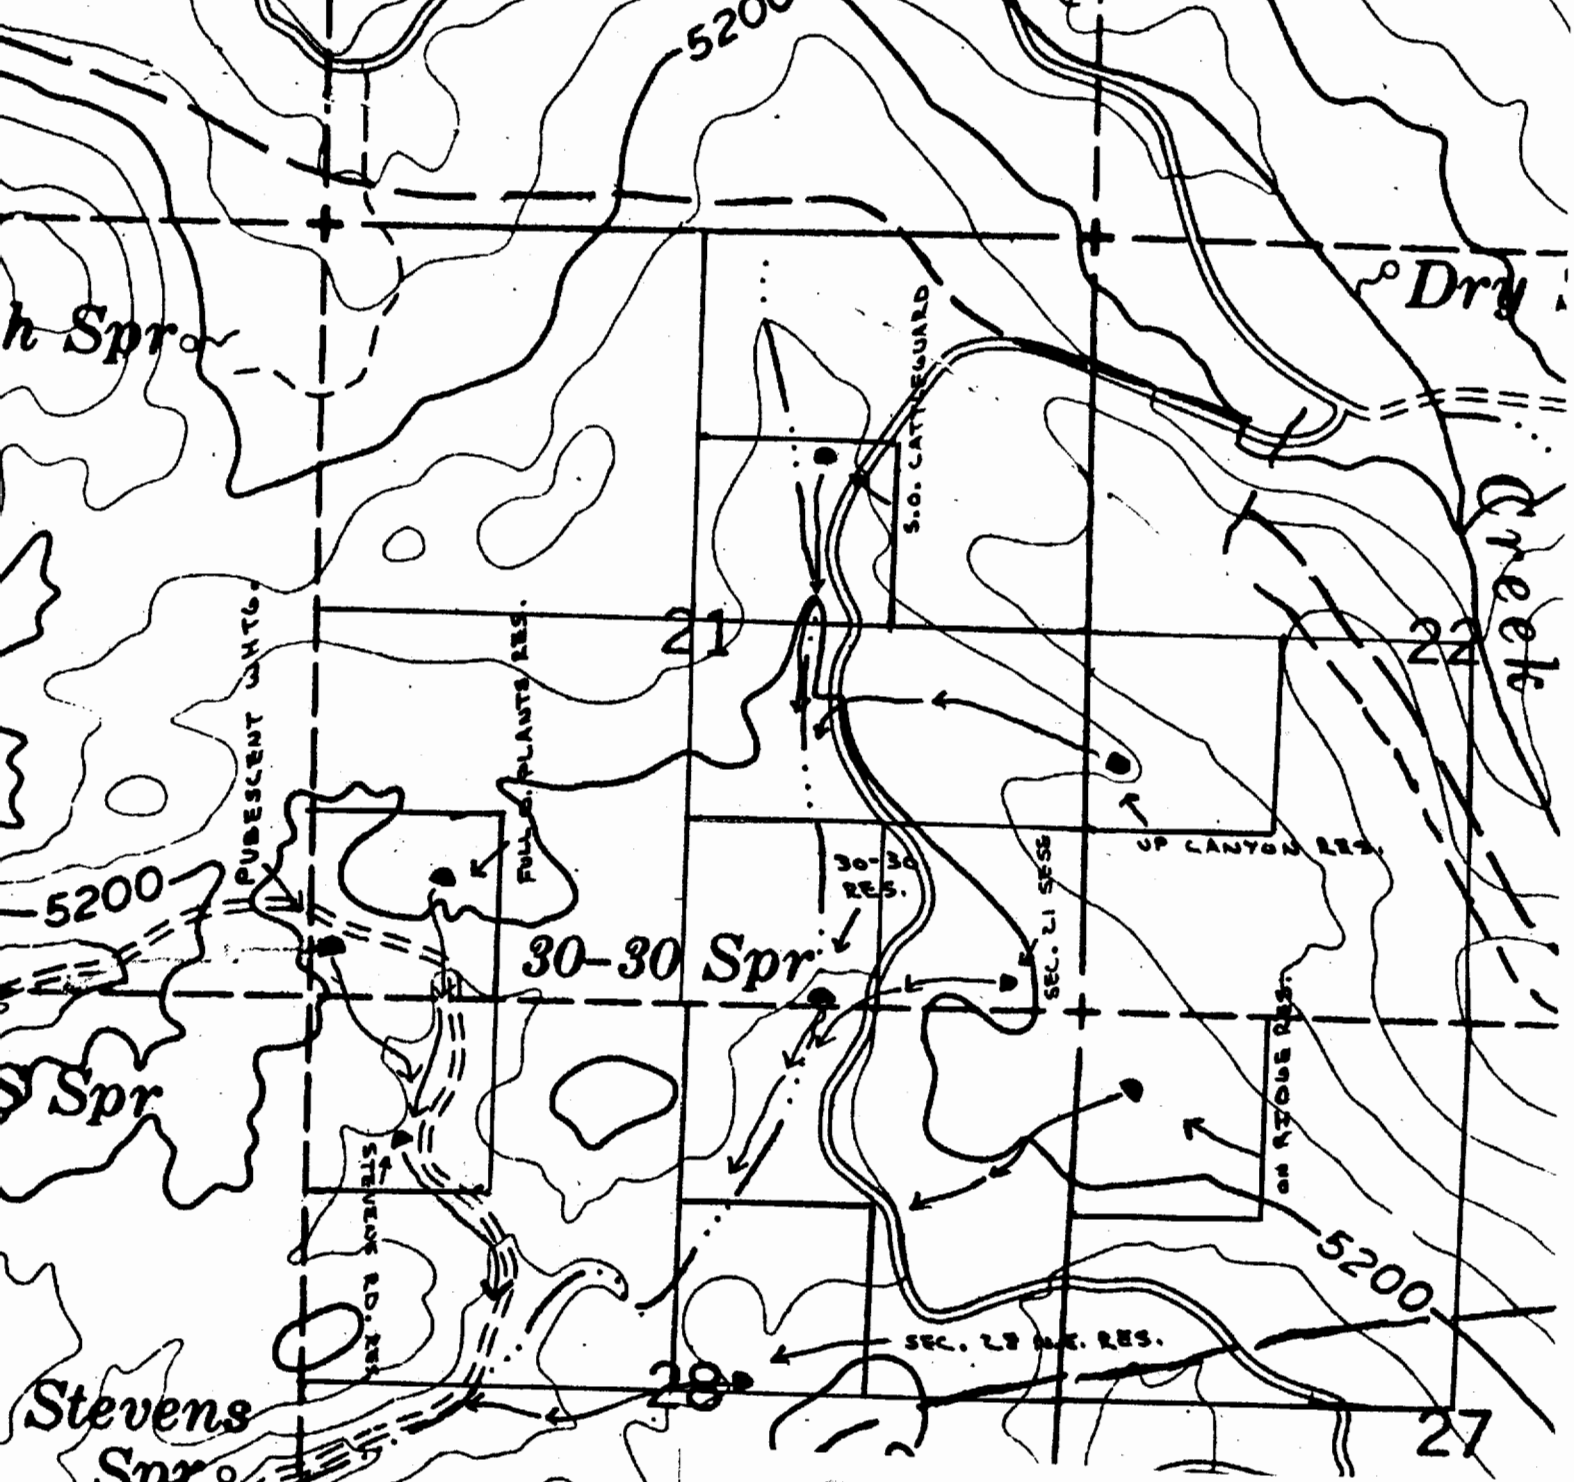

MALHEUR NATIONAL FOREST

STOCK WATER (R8328)

BRIDGE CREEK allotment

SCALE 4 IN. : 1 MILE

T. 17 S. R. 32 E North ↑

application no. R-6[illegible]

RECEIVED

R10406