


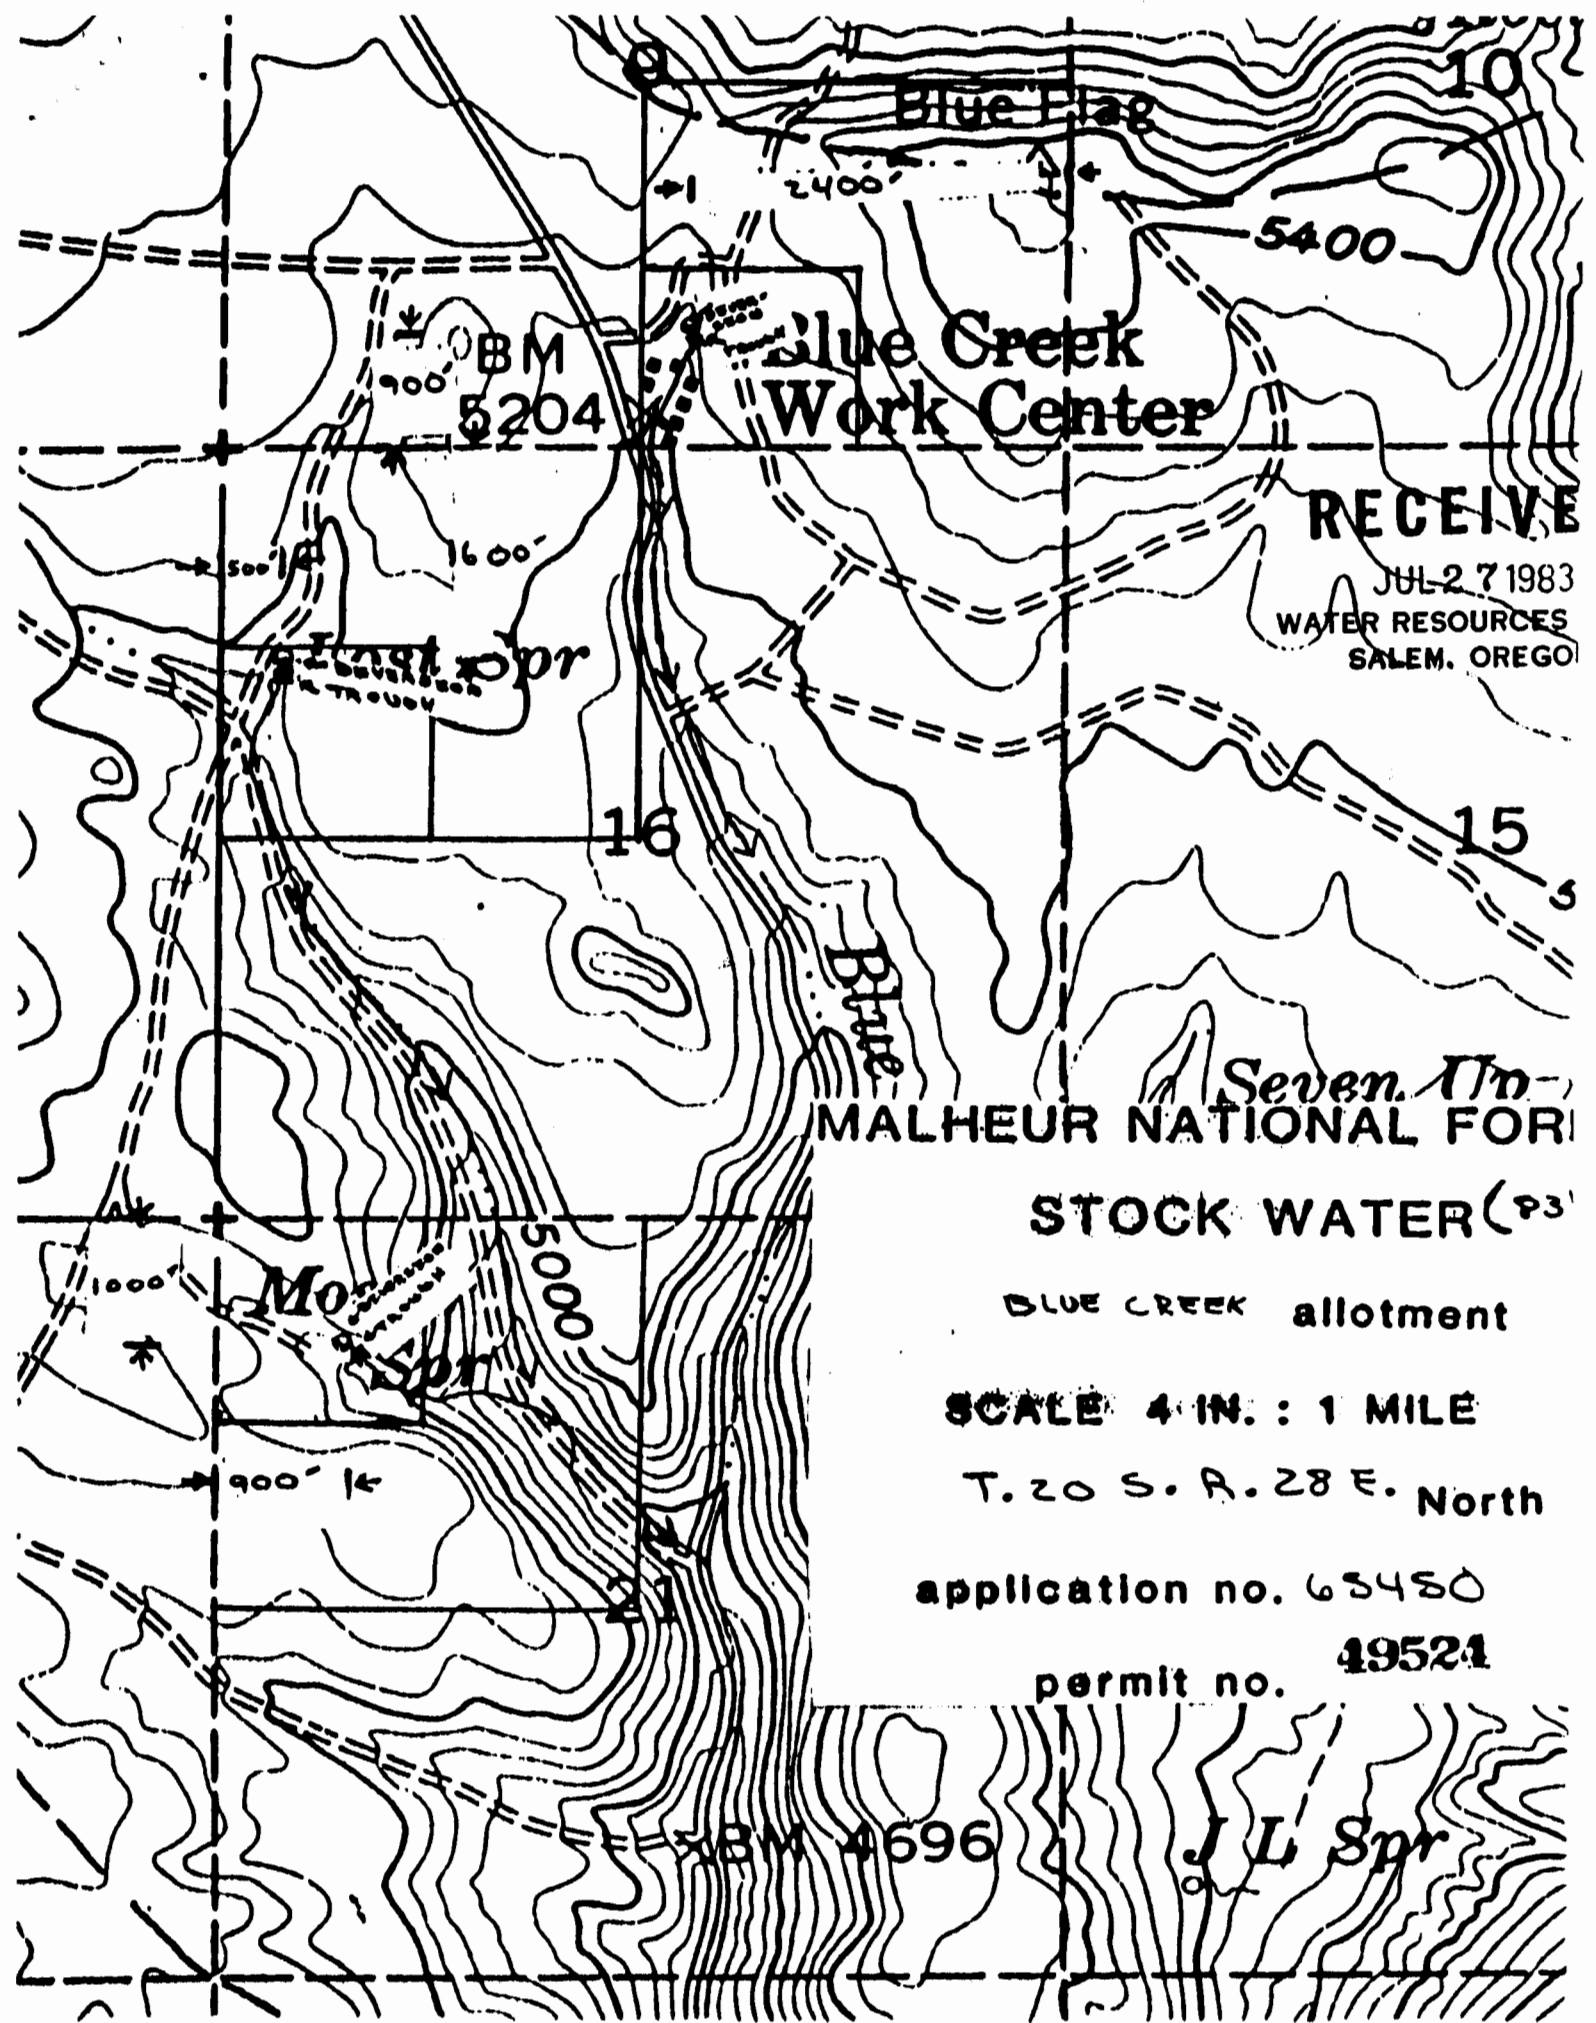

Blue Flag

Blue Creek
Work Center

RECEIVED

JUL 27 1983
WATER RESOURCES
SALEM, OREGON

Seven Mn-
MALHEUR NATIONAL FOR

STOCK WATER (P3)

BLUE CREEK allotment

SCALE 4 IN. : 1 MILE

T. 20 S. R. 28 E. North

application no. 65480

permit no. 49524

BM 4696

J L Spr