



THE PREPARATION OF THIS MAP WAS FOR THE PURPOSE OF IDENTIFYING THE LOCATION OF THE WATER RIGHT ONLY AND HAS NO INTENT TO PROVIDE DIMENSIONS OR LOCATION OF PROPERTY OWNERSHIP

SECTION 7
SECTION 18
T4N, R10W, W.M.
CLATSOP COUNTY, OREGON

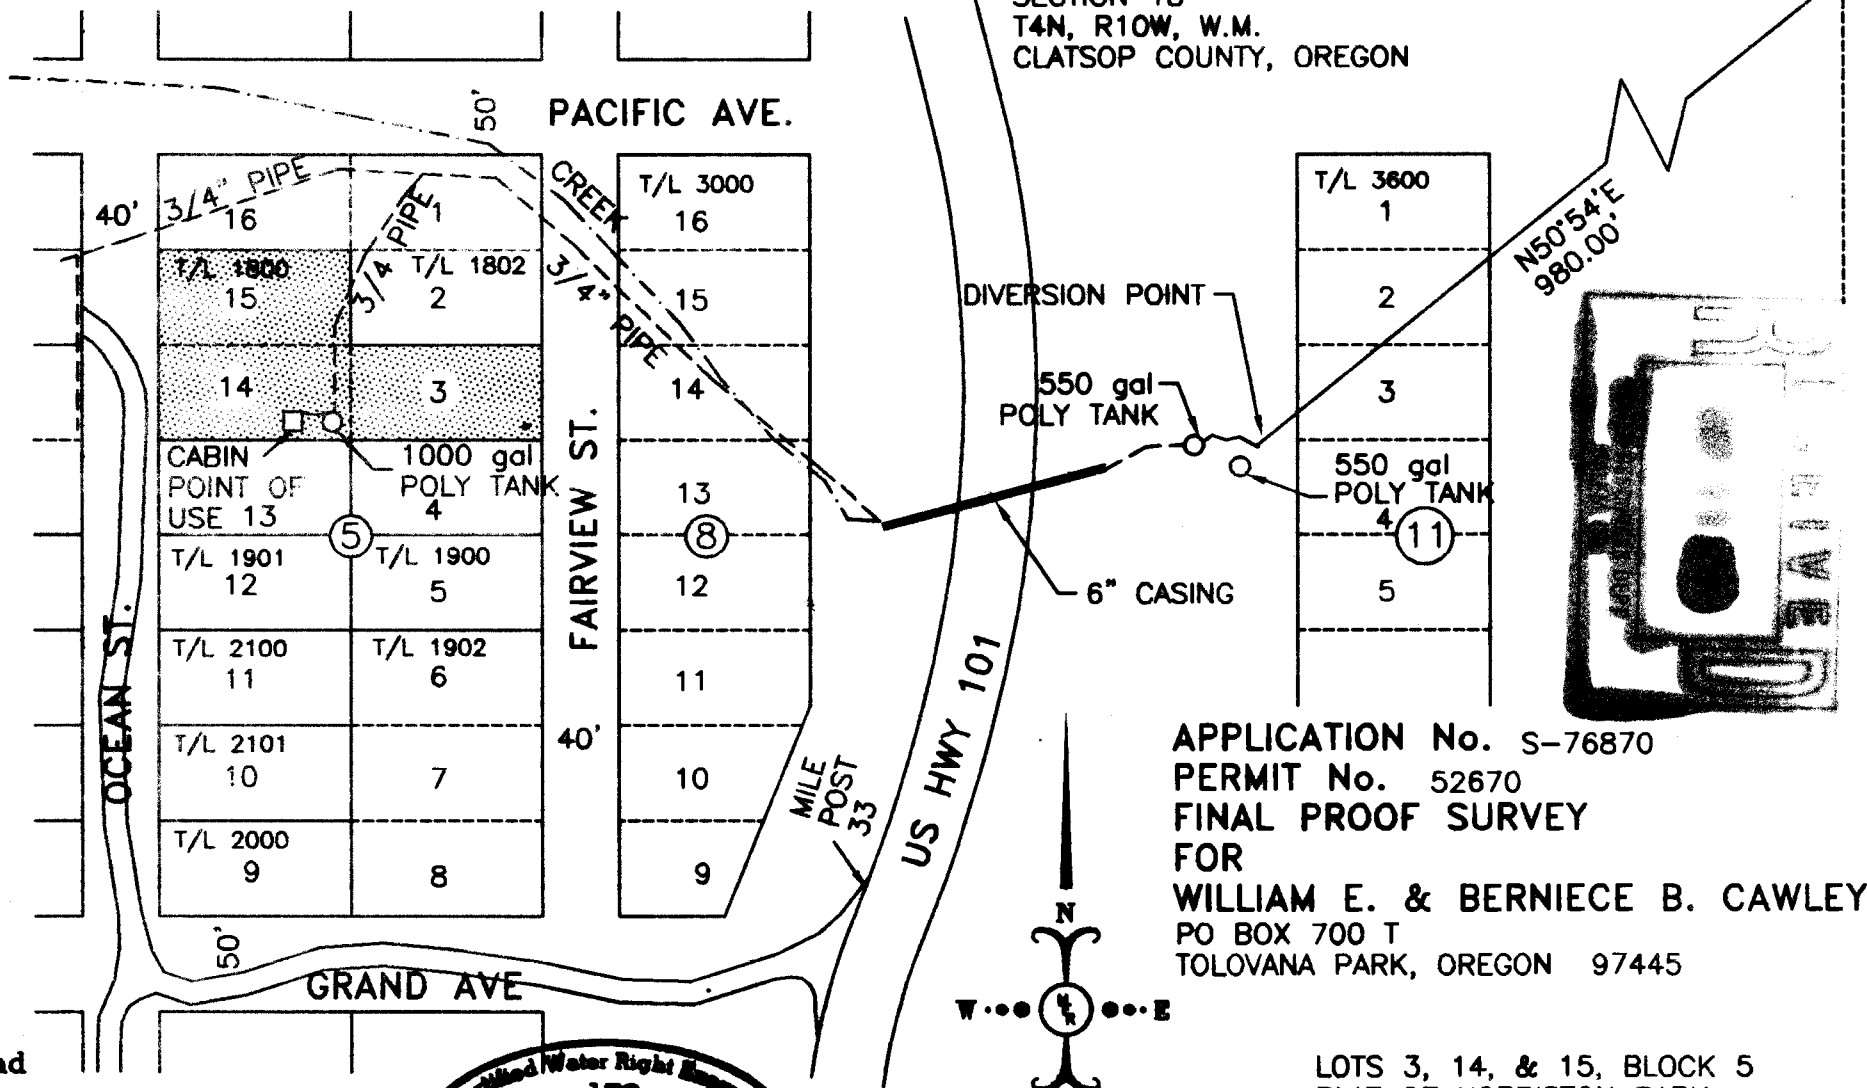


APPLICATION No. S-76870
PERMIT No. 52670
FINAL PROOF SURVEY
FOR
WILLIAM E. & BERNIECE B. CAWLEY
PO BOX 700 T
TOLOVANA PARK, OREGON 97445

LOTS 3, 14, & 15, BLOCK 5
PLAT OF NORRISTON PARK
NE 1/4 NW 1/4 SEC. 18
T4N, R10W, W.M.
CLATSOP COUNTY, OREGON

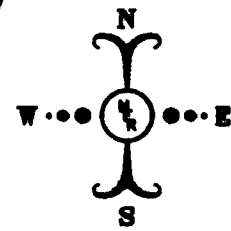

TAX ASSESSOR'S MAP SCALE: 1"=100'
DATE: 22 SEPT. 1999 REVISED 28 AUG. 2000

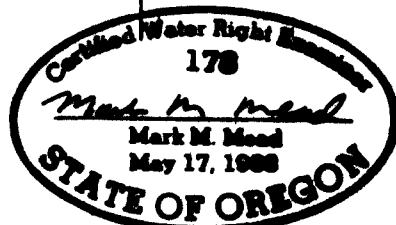

EX-178 12/31/00

Mead
Engineering
Resources inc
90331 HAWKINS ROAD
WARRENTON, OREGON 97146
Ph. 503-861-2604