


THE PREPARATION OF THIS MAP WAS FOR THE PURPOSE OF IDENTIFYING THE LOCATION OF THE WATER RIGHT ONLY AND HAS NO INTENT TO PROVIDE DIMENSIONS OR LOCATION OF PROPERTY OWNERSHIP

1/4 CORNER

SECTION 7
SECTION 18
T4N, R10W, W.M.
CLATSOP COUNTY, OREGON

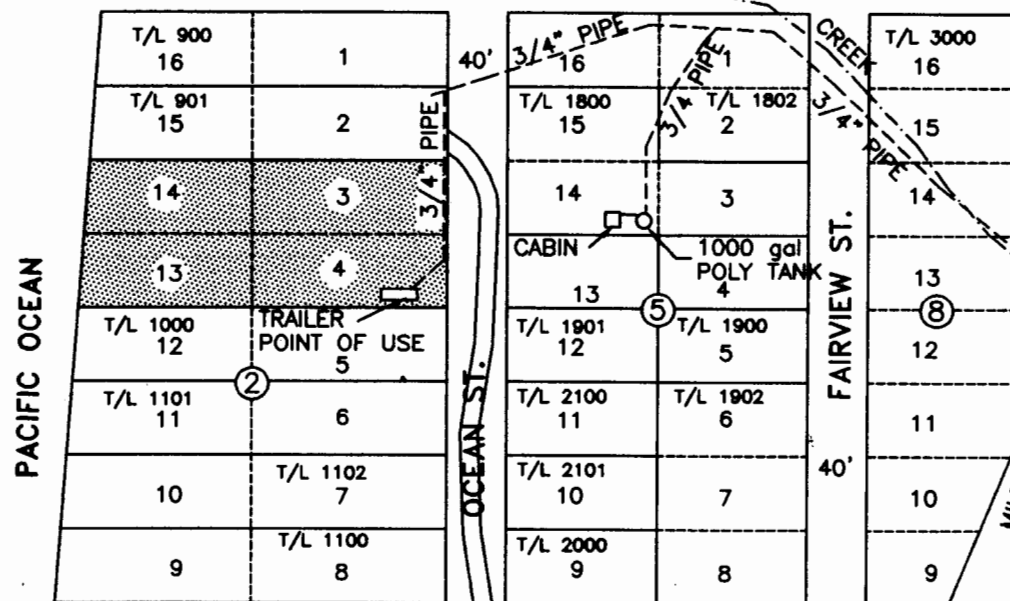

DIVERSION POINT
550 gal POLY TANK
6" CASING

N50°54'E
980.00'


RECEIVED

SEP 11 2000

WATER RESOURCES DEPT.
SALEM, OREGON

APPLICATION No. 70839
PERMIT No. 51364
FINAL PROOF SURVEY
FOR
WILLIAM E. & BERNIECE B. CAWLEY
PO BOX 700 T
TOLOVANA PARK, OREGON 97445

LOTS 3, 4, 13, & 14, BLOCK 2
PLAT OF NORRISTON PARK
NE 1/4 NW 1/4 SEC. 18
T4N, R10W, W.M.
CLATSOP COUNTY, OREGON

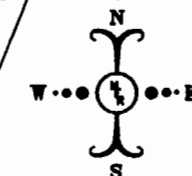

0 50 100

TAX ASSESSOR'S MAP SCALE: 1"=100'
DATE: 22 SEPT. 1999 REVISED 28 AUG. 2000



Expires 12/31/00

Mead
Engineering
Resources inc

90331 HAWKINS ROAD
WARRENTON, OREGON 97146
Ph. 503-861-2604