

EXHIBIT 'A'

T. 32 S., R 5 W., W.M.

SCALE: 1" = 400'



THE PURPOSE OF THIS MAP IS TO IDENTIFY THE LOCATION OF THE WATER RIGHT. IT IS NOT INTENDED TO PROVIDE INFORMATION RELATIVE TO THE LOCATION OF PROPERTY OWNERSHIP BOUNDARY LINES.

POINT OF DIVERSION IS 684 FEET NORTH AND 2666 FEET WEST FROM THE NORTH 1/4 CORNER TO SECTION 14.

POINT OF DIVERSION

AREA OF WATER LINE EASEMENT.

UN-NAMED STREAM


SECTION II
SECTION 14

1/4 COR. FD. B.C.

N.E. 1/4 of N.W. 1/4
7.2 AC.

POWER PLANT LOCATION


CENTER OF 20 FOOT WATER LINE EASEMENT.

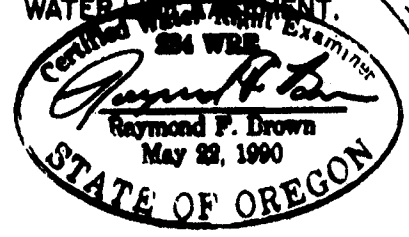

EXP. 12/31/01



AREA AS PER PERMIT # 5313. 4.5 AC.

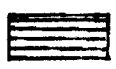

AREA PER PERMIT # 23185. 2.7 AC.

BARN

POND

SHED

SHED

FORREST DRIVE

OLD PACIFIC HWY.

RECEIVED
MAR 21 2003
WATER RESOURCES DEPT
SALEM, OREGON

RICHARD D. JONES

Surveyed: AUG. 3, 2001 by: R.F. BROWN.