


T.12S.R.1W.W.M.

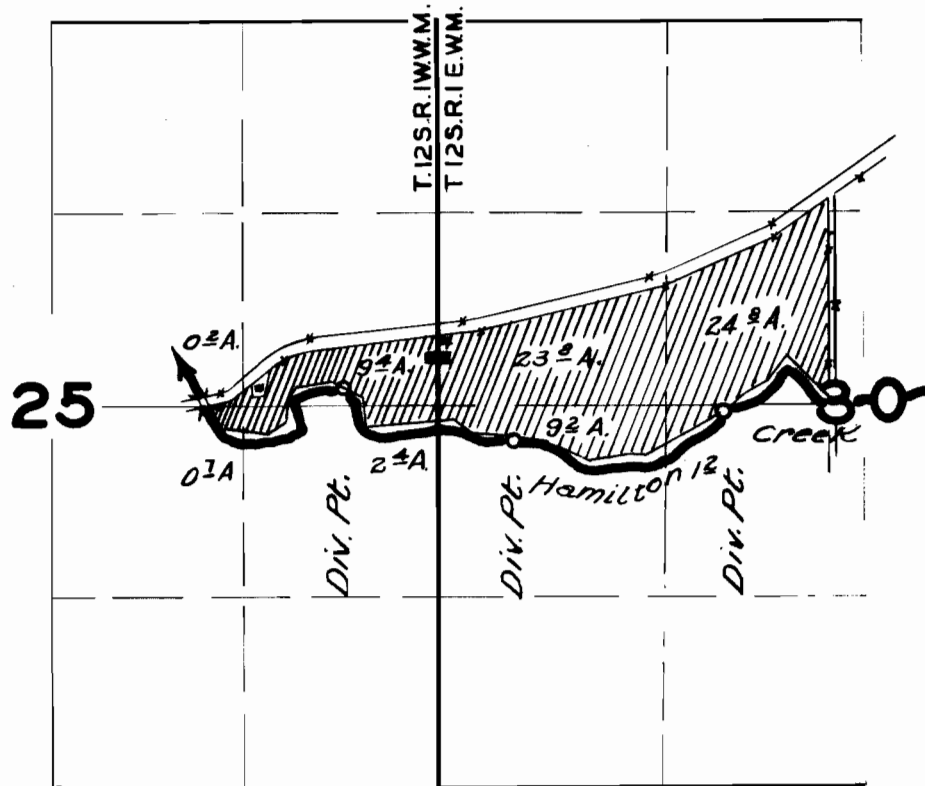

FINAL PROOF SURVEY

UNDER

Application No. 24641 Permit No. 19473

IN NAME OF

A. V. GILBERT

Surveyed APR. 20 1951, by H.L. COFFMAN