


T.IOS.,R.IE.,W.M.

RECEIVED

SEP 19 1996

WATER RESOURCES DEPT
SALEM, OREGON

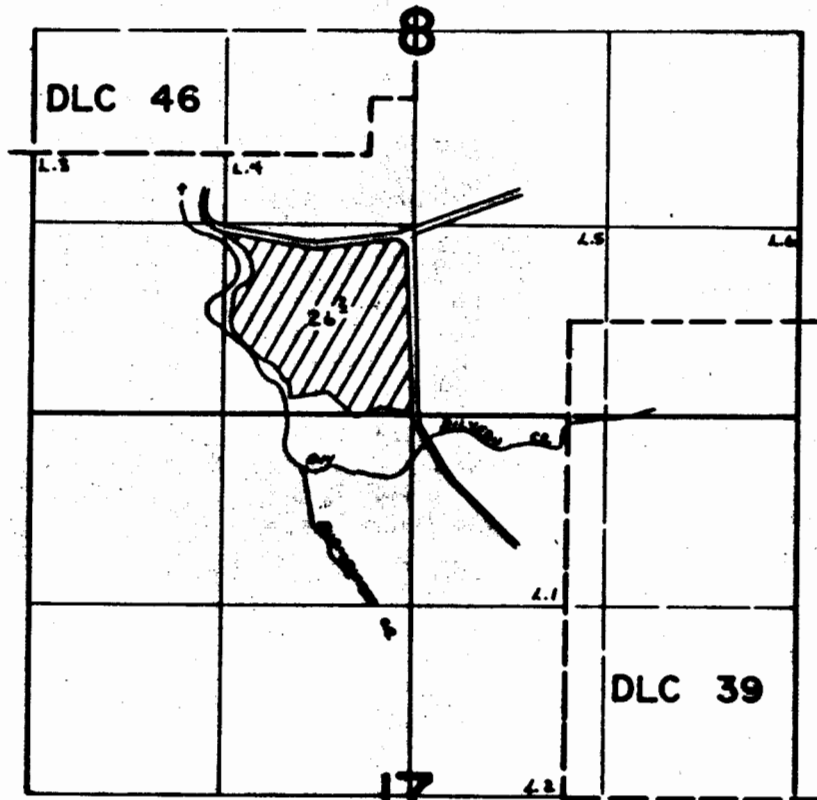


DIV. PT.: 390' S AND 740' W FROM N 1/4 COR. SEC. 17

FINAL PROOF SURVEY FOR

RON BENTZ

TRANSFER T-7036

THIS MAP WAS PREPARED FOR THE
PURPOSE OF IDENTIFYING THE LOCA-
TION OF A WATER RIGHT ONLY AND IS
NOT INTENDED TO PROVIDE LEGAL
DIMENSIONS OR LOCATION OF PROPER-
TY OWNERSHIP LINES.

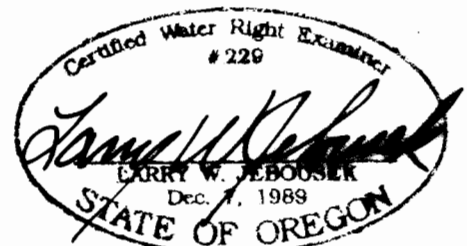

Inspection of L. Tolls F.P.S. for T-2838 of April 22, 1975 on July 31, 1996