



T.2S. R.12E. W.M.

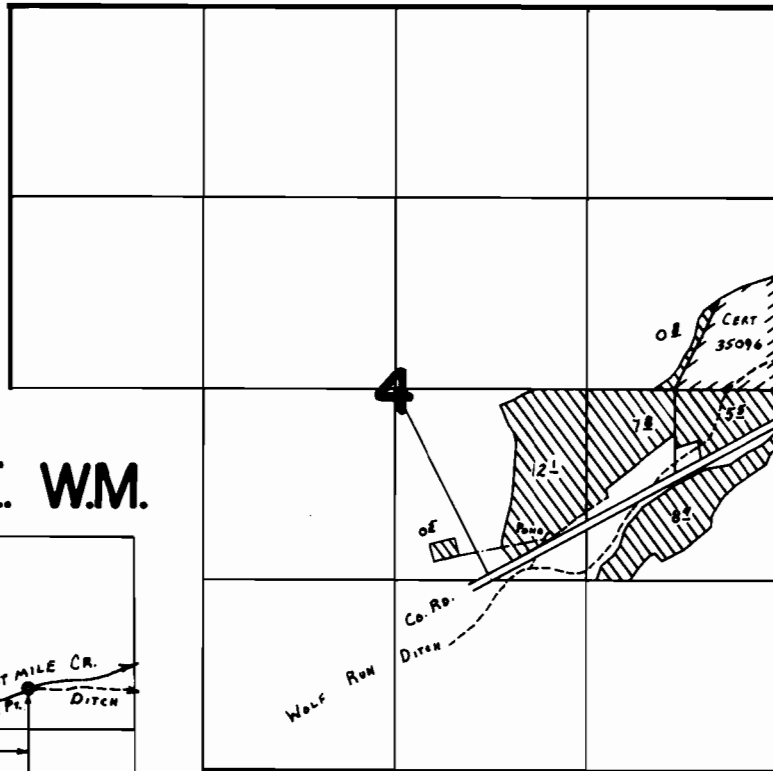

T.2S. R.11E. W.M.

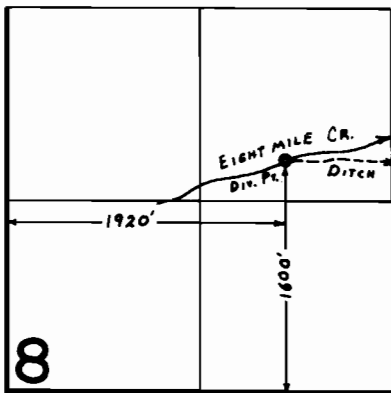

78

FINAL PROOF SURVEY UNDER

Application No. .50777.. Permit No. .37758.....
IN NAME OF
RICHARD C. CANTRELL
SUNE CARL & ETHEL JOHNSON
GEORGE H. & VIRGINIA C. WHITELEY
Surveyed June...27, 1979., by G.L. HUGHES.....