


AMENDED TRANSFER APPLICATION MAP

Located in the NW¼ of Section 25,
Township 27 South, Range 12 West, W.M.
Coos County, Oregon
Permit #29480 Certificate #45028

Scale 1" = 400 Feet

PREPARED FOR: WALTER & WENDY HAZEN
PREPARED BY: DENNIS GOUDE
PREPARED: APRIL 15, 2003

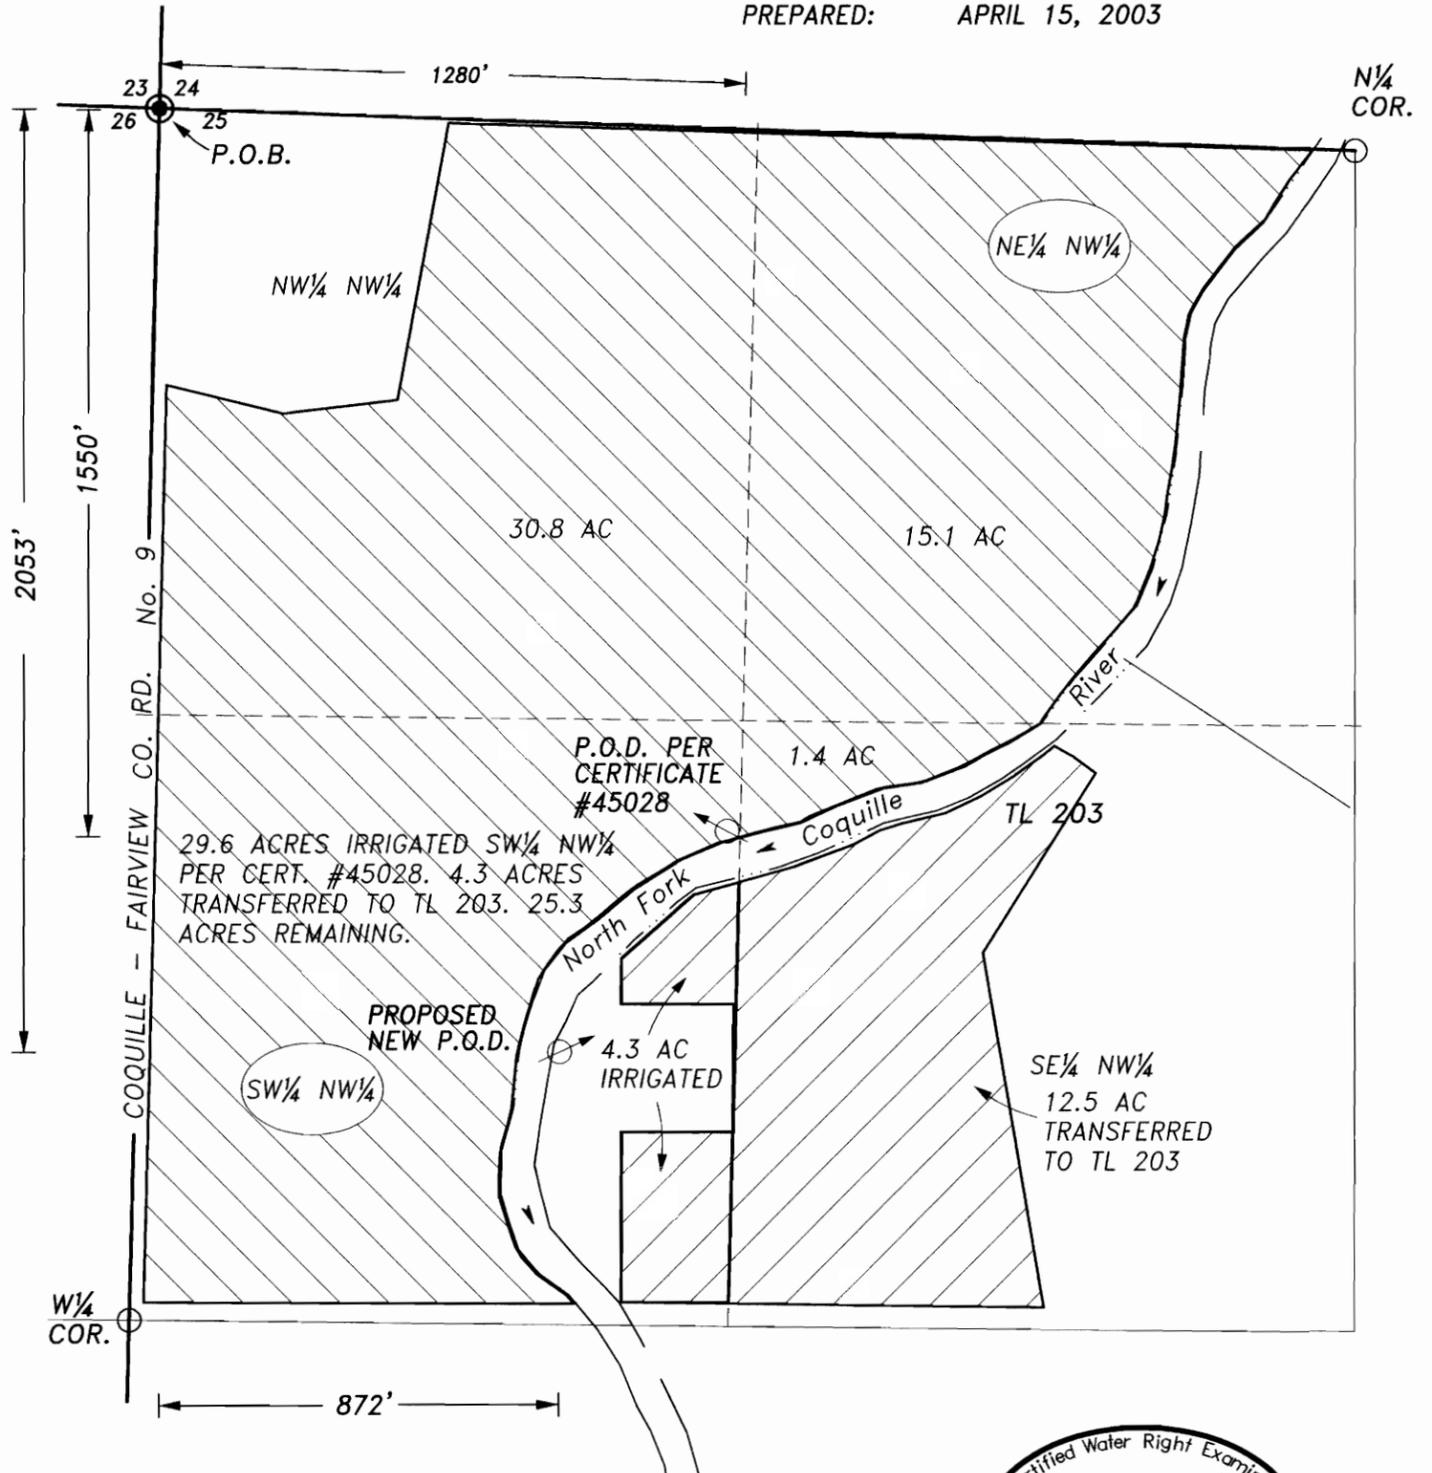

NOTE:

PLACES OF USE PER CERTIFICATE 45028

NW¼ NW¼	30.8 ACRES
NE¼ NW¼	15.1 ACRES
SW¼ NW¼	29.6 ACRES
SE¼ NW¼	13.9 ACRES

PLACES OF USE TRANSFERRED TO ADDITIONAL P.O.D. FOR TAX LOT 203.

SW¼ NW¼	4.3 ACRES
SE¼ NW¼	12.5 ACRES

NOTE:

THE PURPOSE OF THIS APPLICATION IS FOR AN ADDITIONAL POINT OF DIVERSION FOR THE PORTION OF CERTIFICATE 45028 THAT COVERS TAX LOT 203. THE NEW P.O.D. WILL BE 2053 FEET SOUTH AND 872 FEET EAST FORM THE NORTHWEST CORNER OF SECTION 25. ALSO, NOTE IRRIGATED ACRES PER RECORD NOT FIELD VERIFIED AT THIS TIME.



EXPIRES 06/30/2005

LEGEND

RIVER	---
POINT OF DIVERSION	P.O.D.
POINT OF BEGINNING	P.O.B.
PLACE OF USE AS TRANSFERRED TO TAX LOT 203	
RECORD PLACE OF USE NOT INVOLVED IN PROPOSED P.O.D. TRANSFER	


Stuntzner Engineering & Forestry

705 So. 4th Street
P.O. Box 118
Coos Bay, Oregon 97420
Phone (541) 267-2872
Fax (541) 267-0588

EXAMINERS DISCLAIMER STATEMENT

The preparation of this map was for the purpose of identifying the location of the Water Right only and has no intent to provide dimensions or location of property ownership lines.

T.27S.R.12W.W.M.

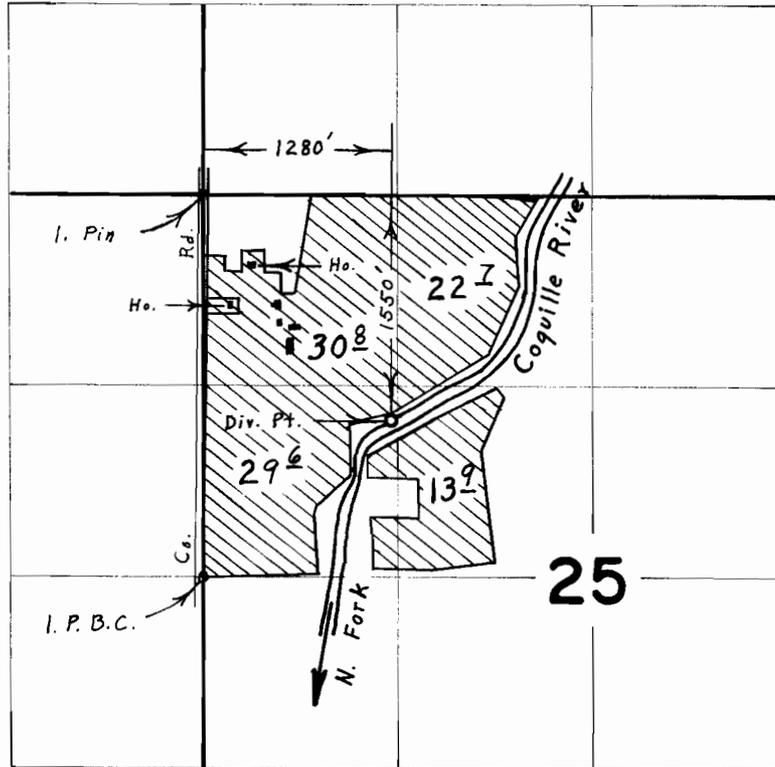

FINAL PROOF SURVEY
UNDER

Application No. 39677... Permit No. 29480
IN NAME OF

LESTER W. & LOUISE GARDNER

Surveyed Oct. 8, 1966, by L. E. Gould