


T.27S.R.12W.W.M.

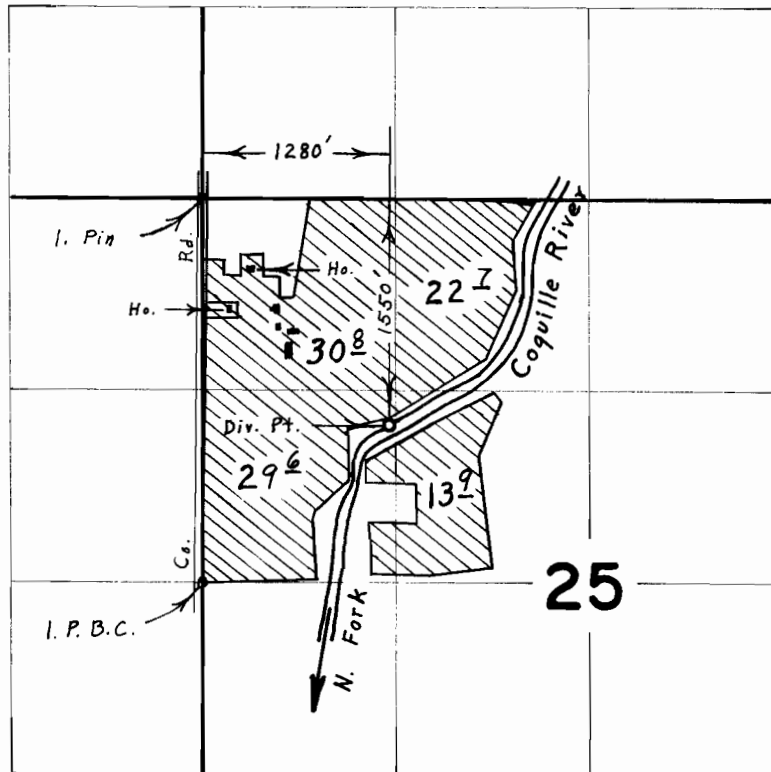

**FINAL PROOF SURVEY**  
UNDER

Application No. 39677... Permit No. 29480.  
IN NAME OF

**LESTER W. & LOUISE GARDNER**

Surveyed Oct. 8, 1966, by L. E. Gould