


G-10159

80875

80796

T. 27 S., R. 18 E., W.M.

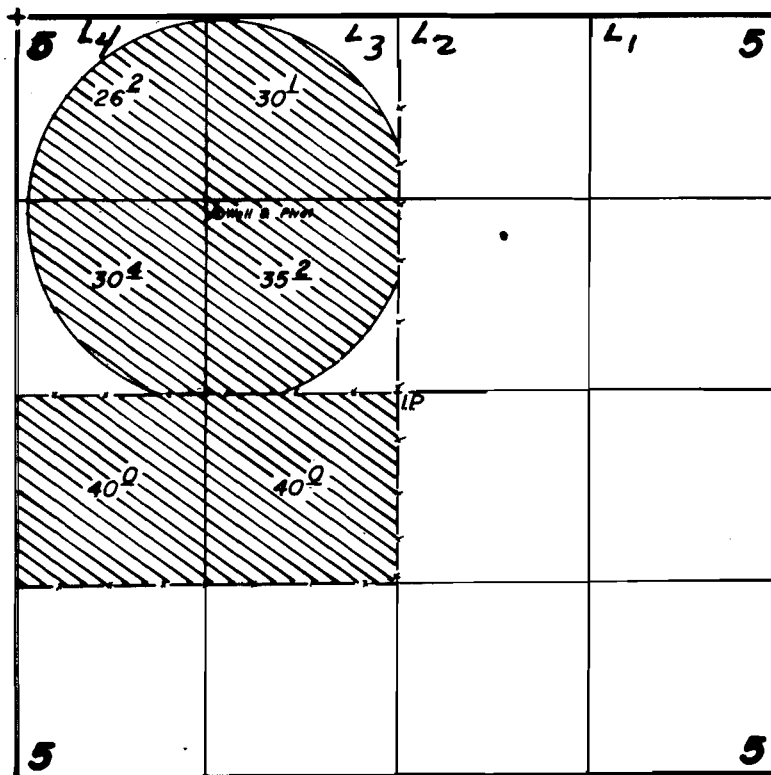

Well location: 1350' S. & 1390' E. from NW Cor. Sec. 5.

1" = 1320'

FINAL PROOF SURVEY

UNDER

Application No. G-11004. Permit No. G-10159....

IN NAME OF

Lawrence & Taralee Grassman

Surveyed Oct...30... 1984., by Leslie Olson....

name
revised 4/30/88
PTS-11-1984-D

T.M.W.