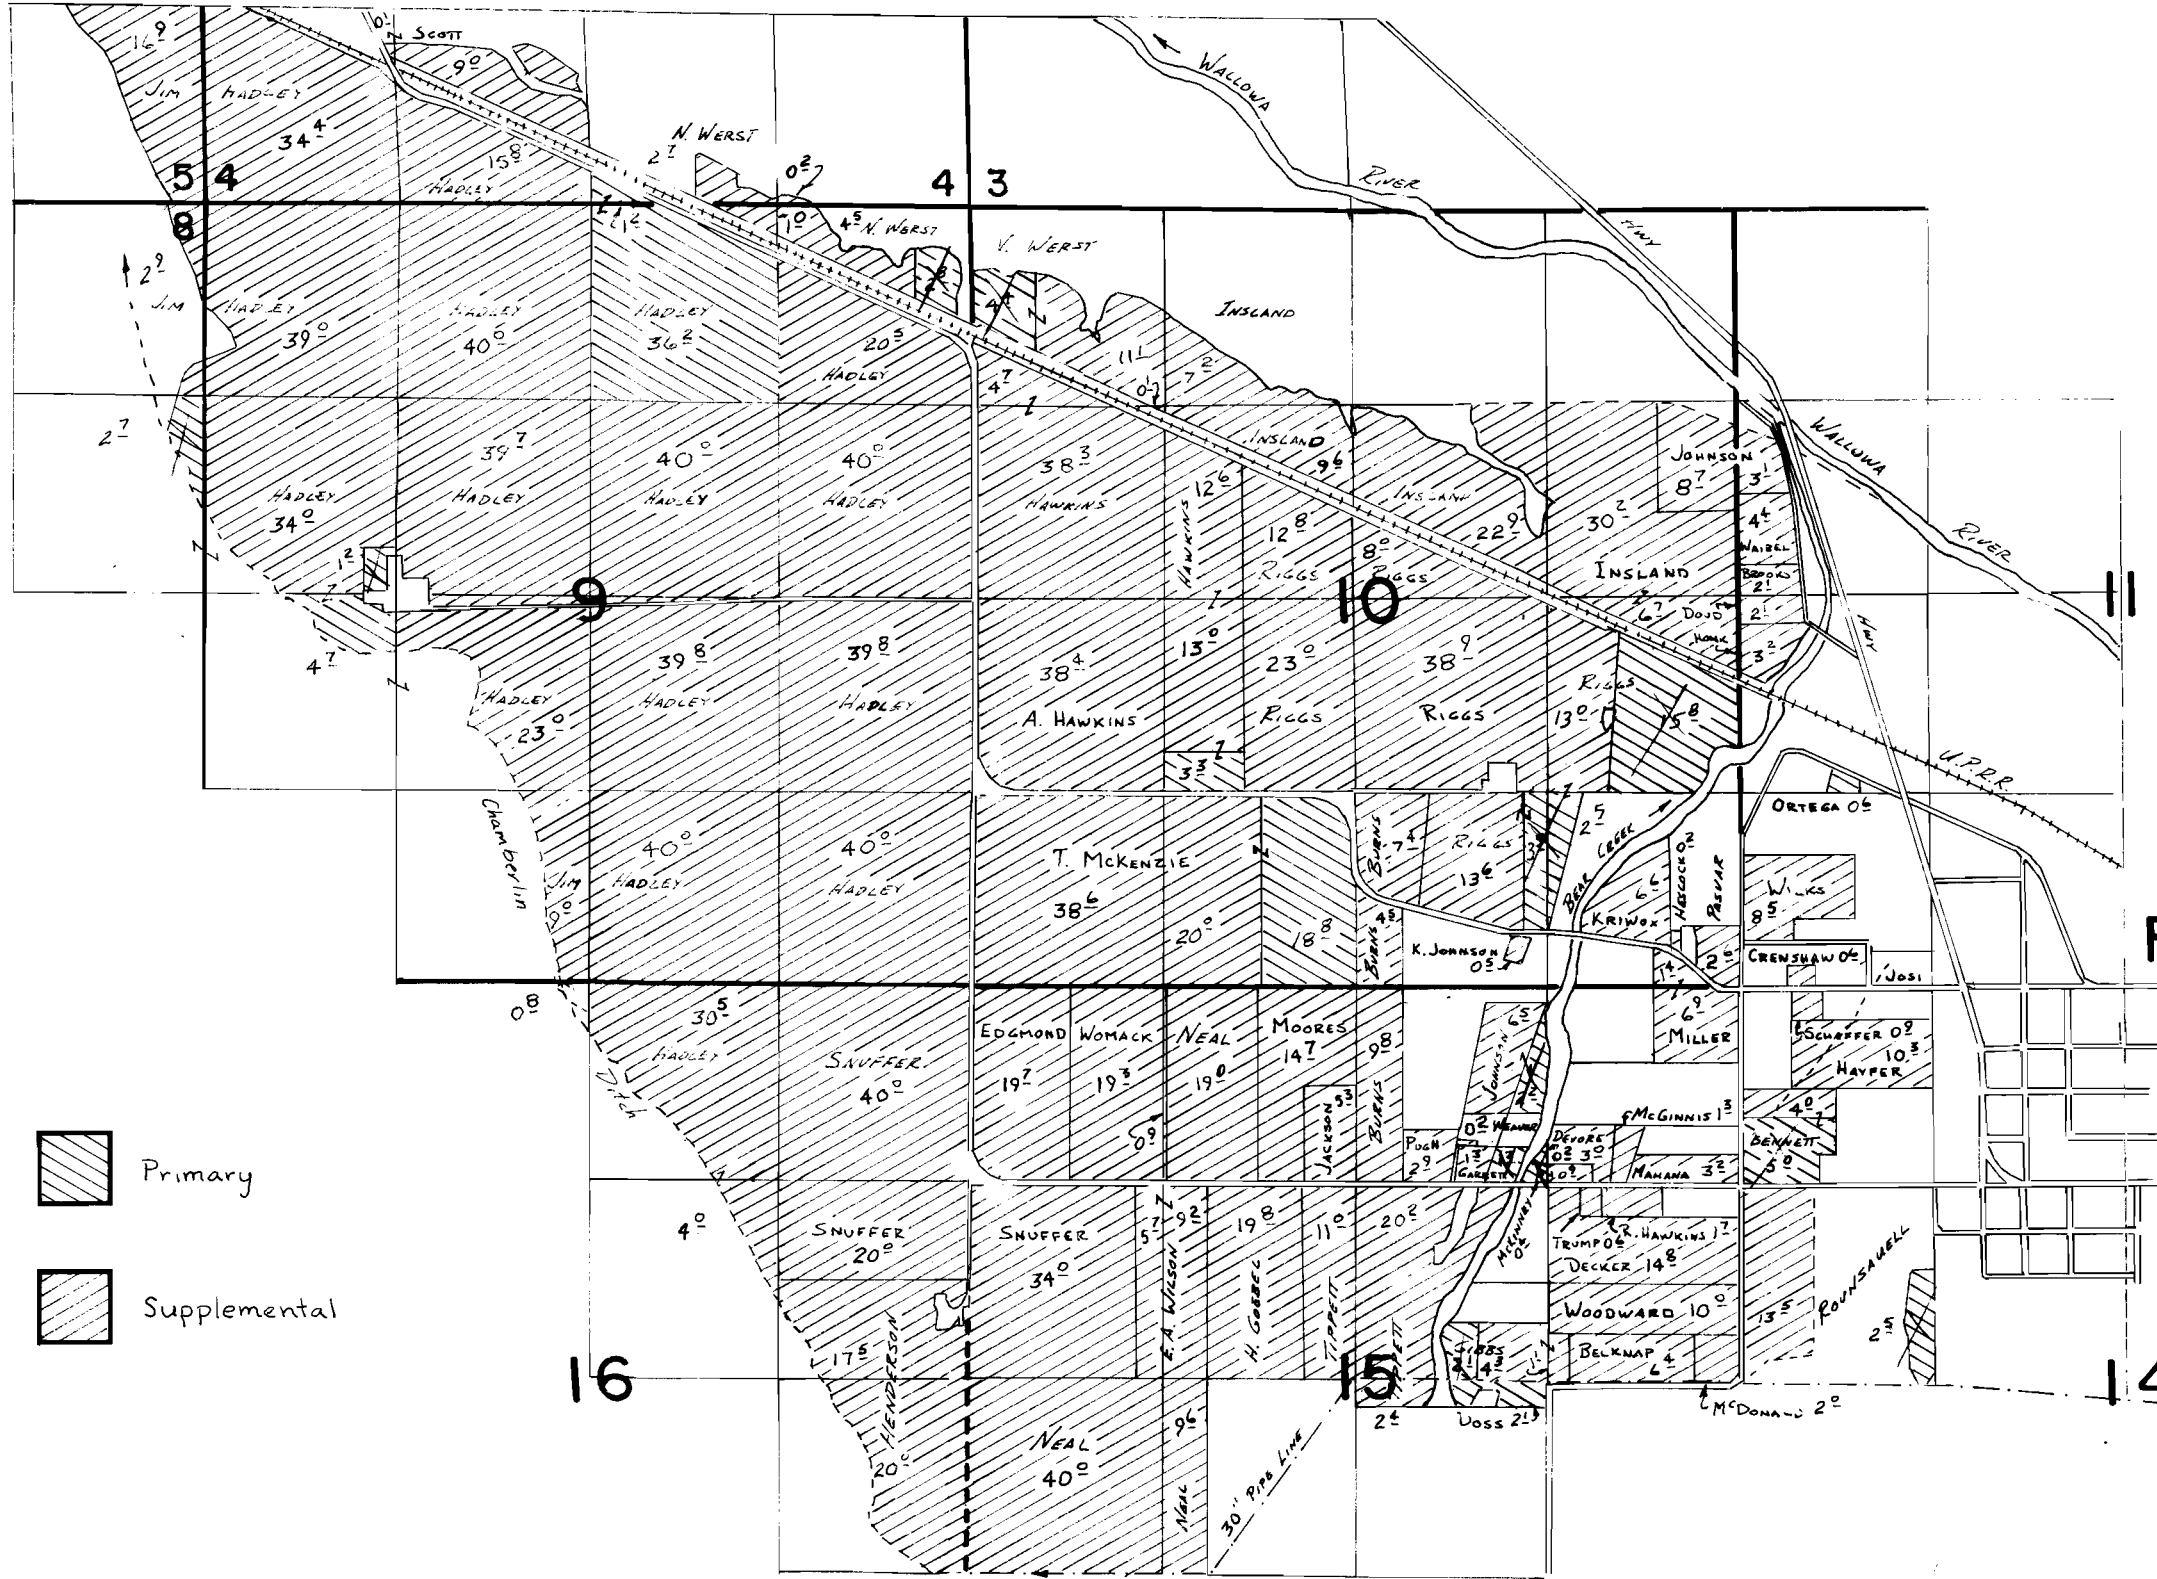
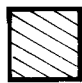

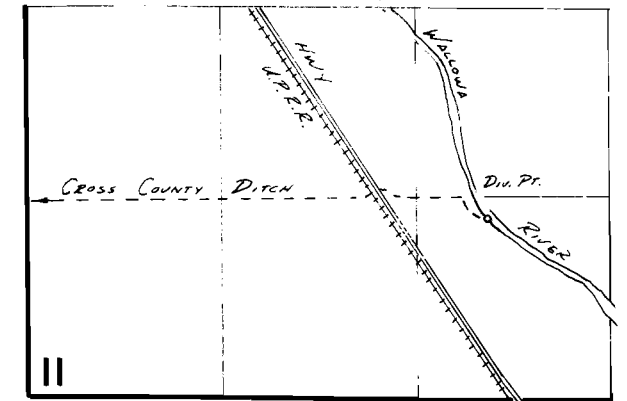


T. 1N., R. 42E., W.M.



-  Primary
-  Supplemental

T. 1S., R. 43E., W.M.



Div. Pt. Loc: 1260' N. + 3170' E FROM SW COR.
SEC. 11

FINAL PROOF SURVEY UNDER

APPL. 48044 PER. 36047
IN NAME OF

CHAMBERLIN DITCH COMPANY
SURVEYED 9/24-28, 1983, BY *J. L. Church*