


T.28S.,R.16E.,W.M.

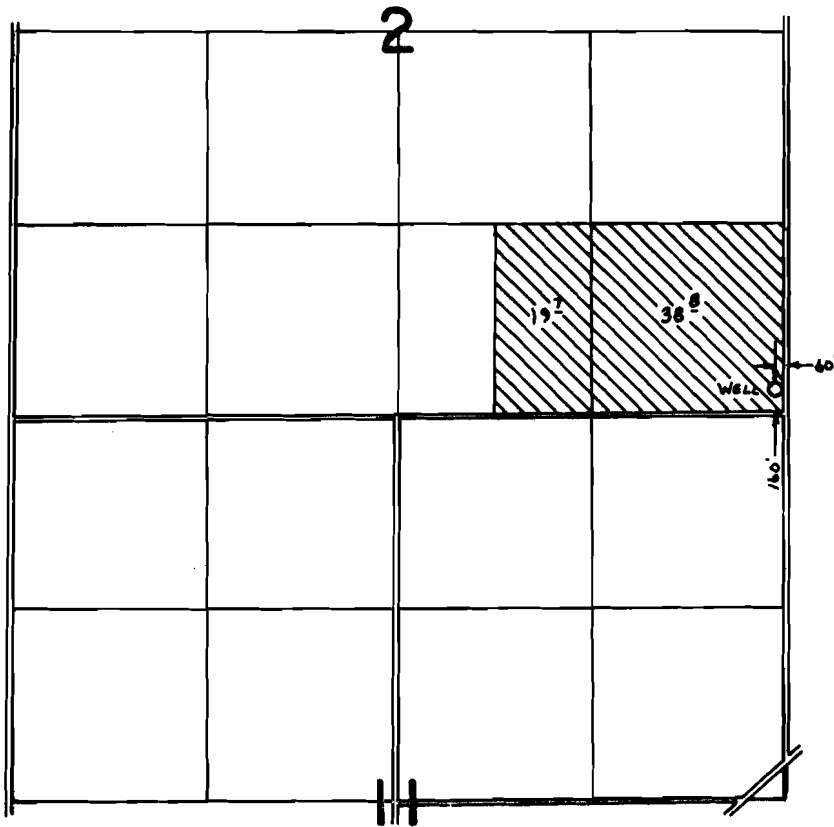

FINAL PROOF SURVEY UNDER

Application No. .G:6221. Permit No. .G:5875.....
IN NAME OF

ERNEST...P...&...JESSIE...O...TUCKER

Surveyed July..25... 19.83., by .L..M...TOLL.....