


# T. 1S. R. 13E. W.M.

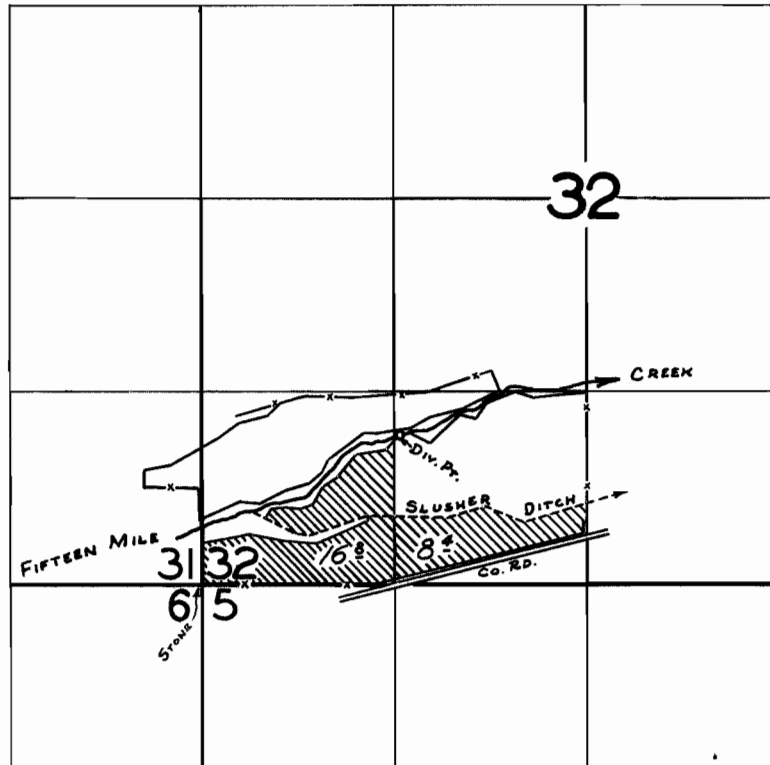

## FINAL PROOF SURVEY UNDER

Application No. 31543 Permit No. 24896  
IN NAME OF

WILLIAM L. & MASIL HULSE

Surveyed Nov. 10 1959, by R. H. JACKSON