


T.6N.R.35E.W.M.

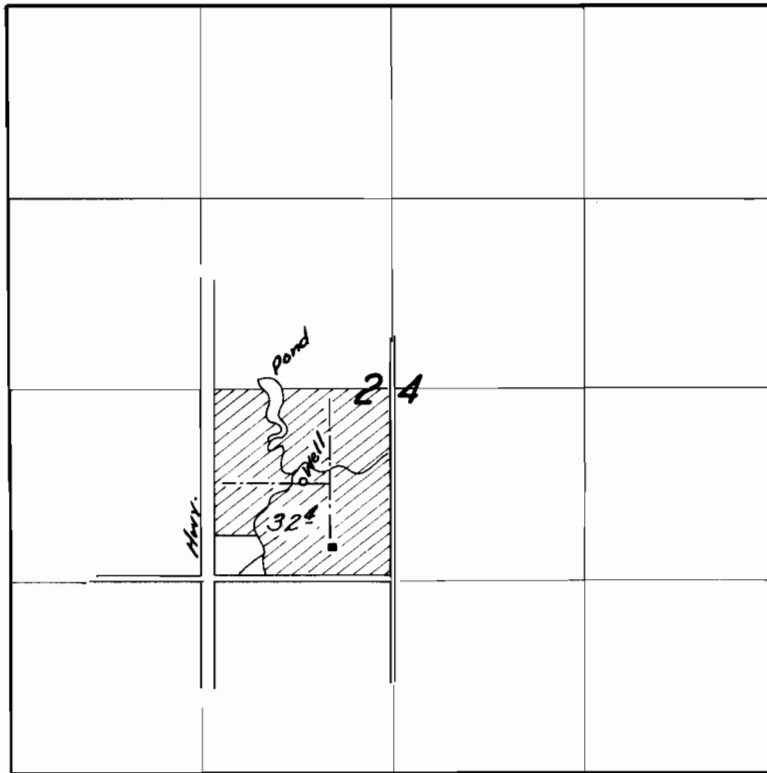

**FINAL PROOF SURVEY**

UNDER

Application No. U-314 Permit No. U-288

IN NAME OF

Ralph R. Clark

Surveyed Oct 26 1959, by C. O. Baette