


T.5&6N. R.35&36E W.M.

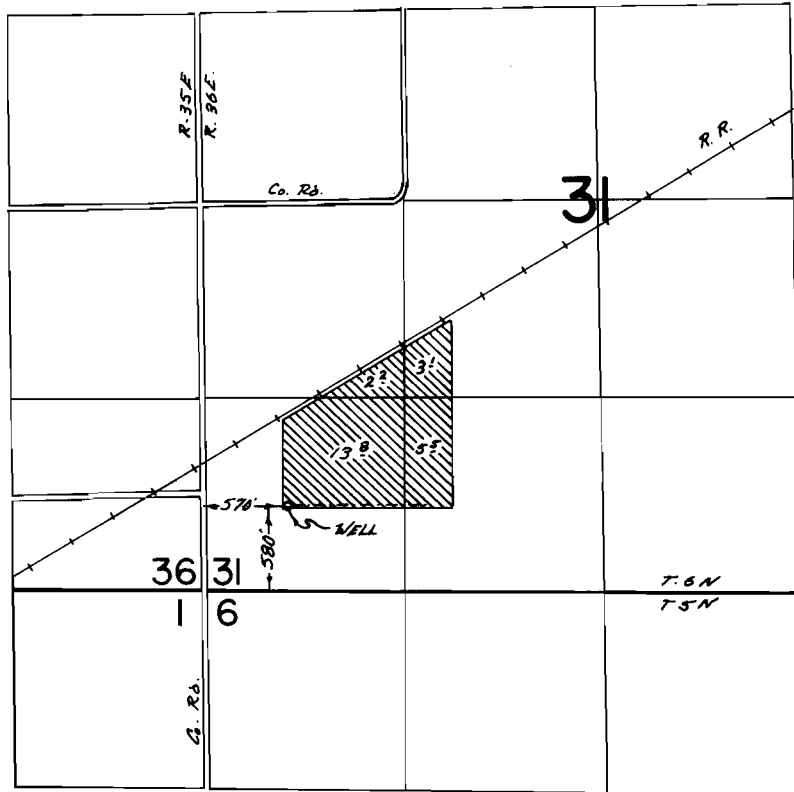

FINAL PROOF SURVEY
UNDER

Application No. G-4281 Permit No. G-4014
IN NAME OF

ESTATE OF J. WALDO BRADSHAW

Surveyed APRIL 12, 1979, by R. G. MUCKEN