


Sept. - 16 - 1912,

Application No. 2573
Permit No. 1464

T 22 S. R. 23 E. W m. N. W. $\frac{1}{4}$ Sec. 23.

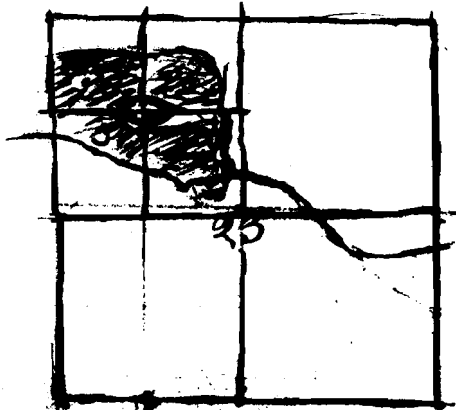

Bulger Cr

Div. in SENW 23-22S-23E