


T. 6. N. R. 35 & 36 E. W. M.

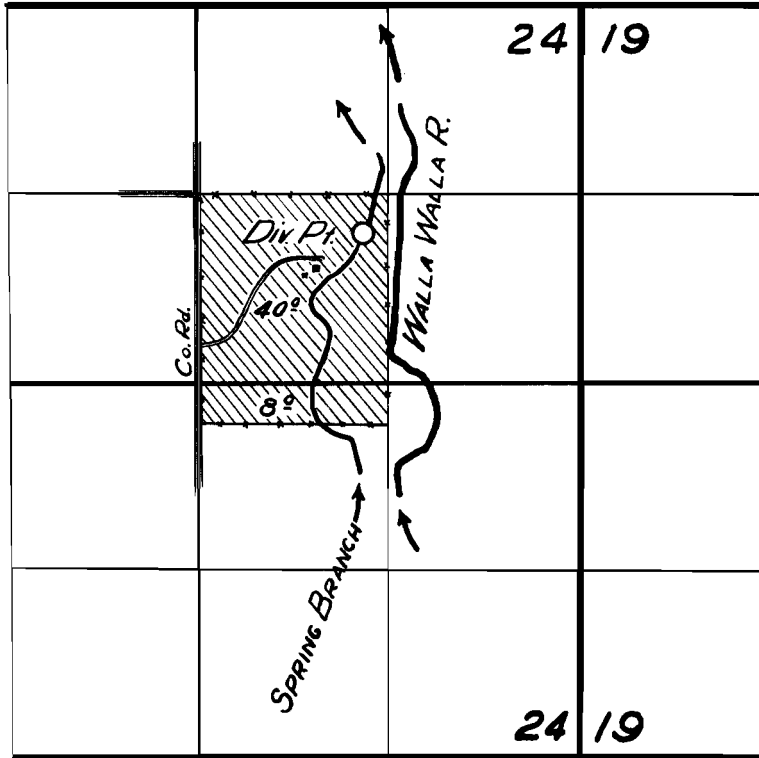

FINAL PROOF SURVEY
UNDER

Application No. 24507 Parcel No. 19303

IN NAME OF

WILLIAM & CHARLOTTE NEELEY

Surveyed 6 Nov. 1955, by *[Signature]*